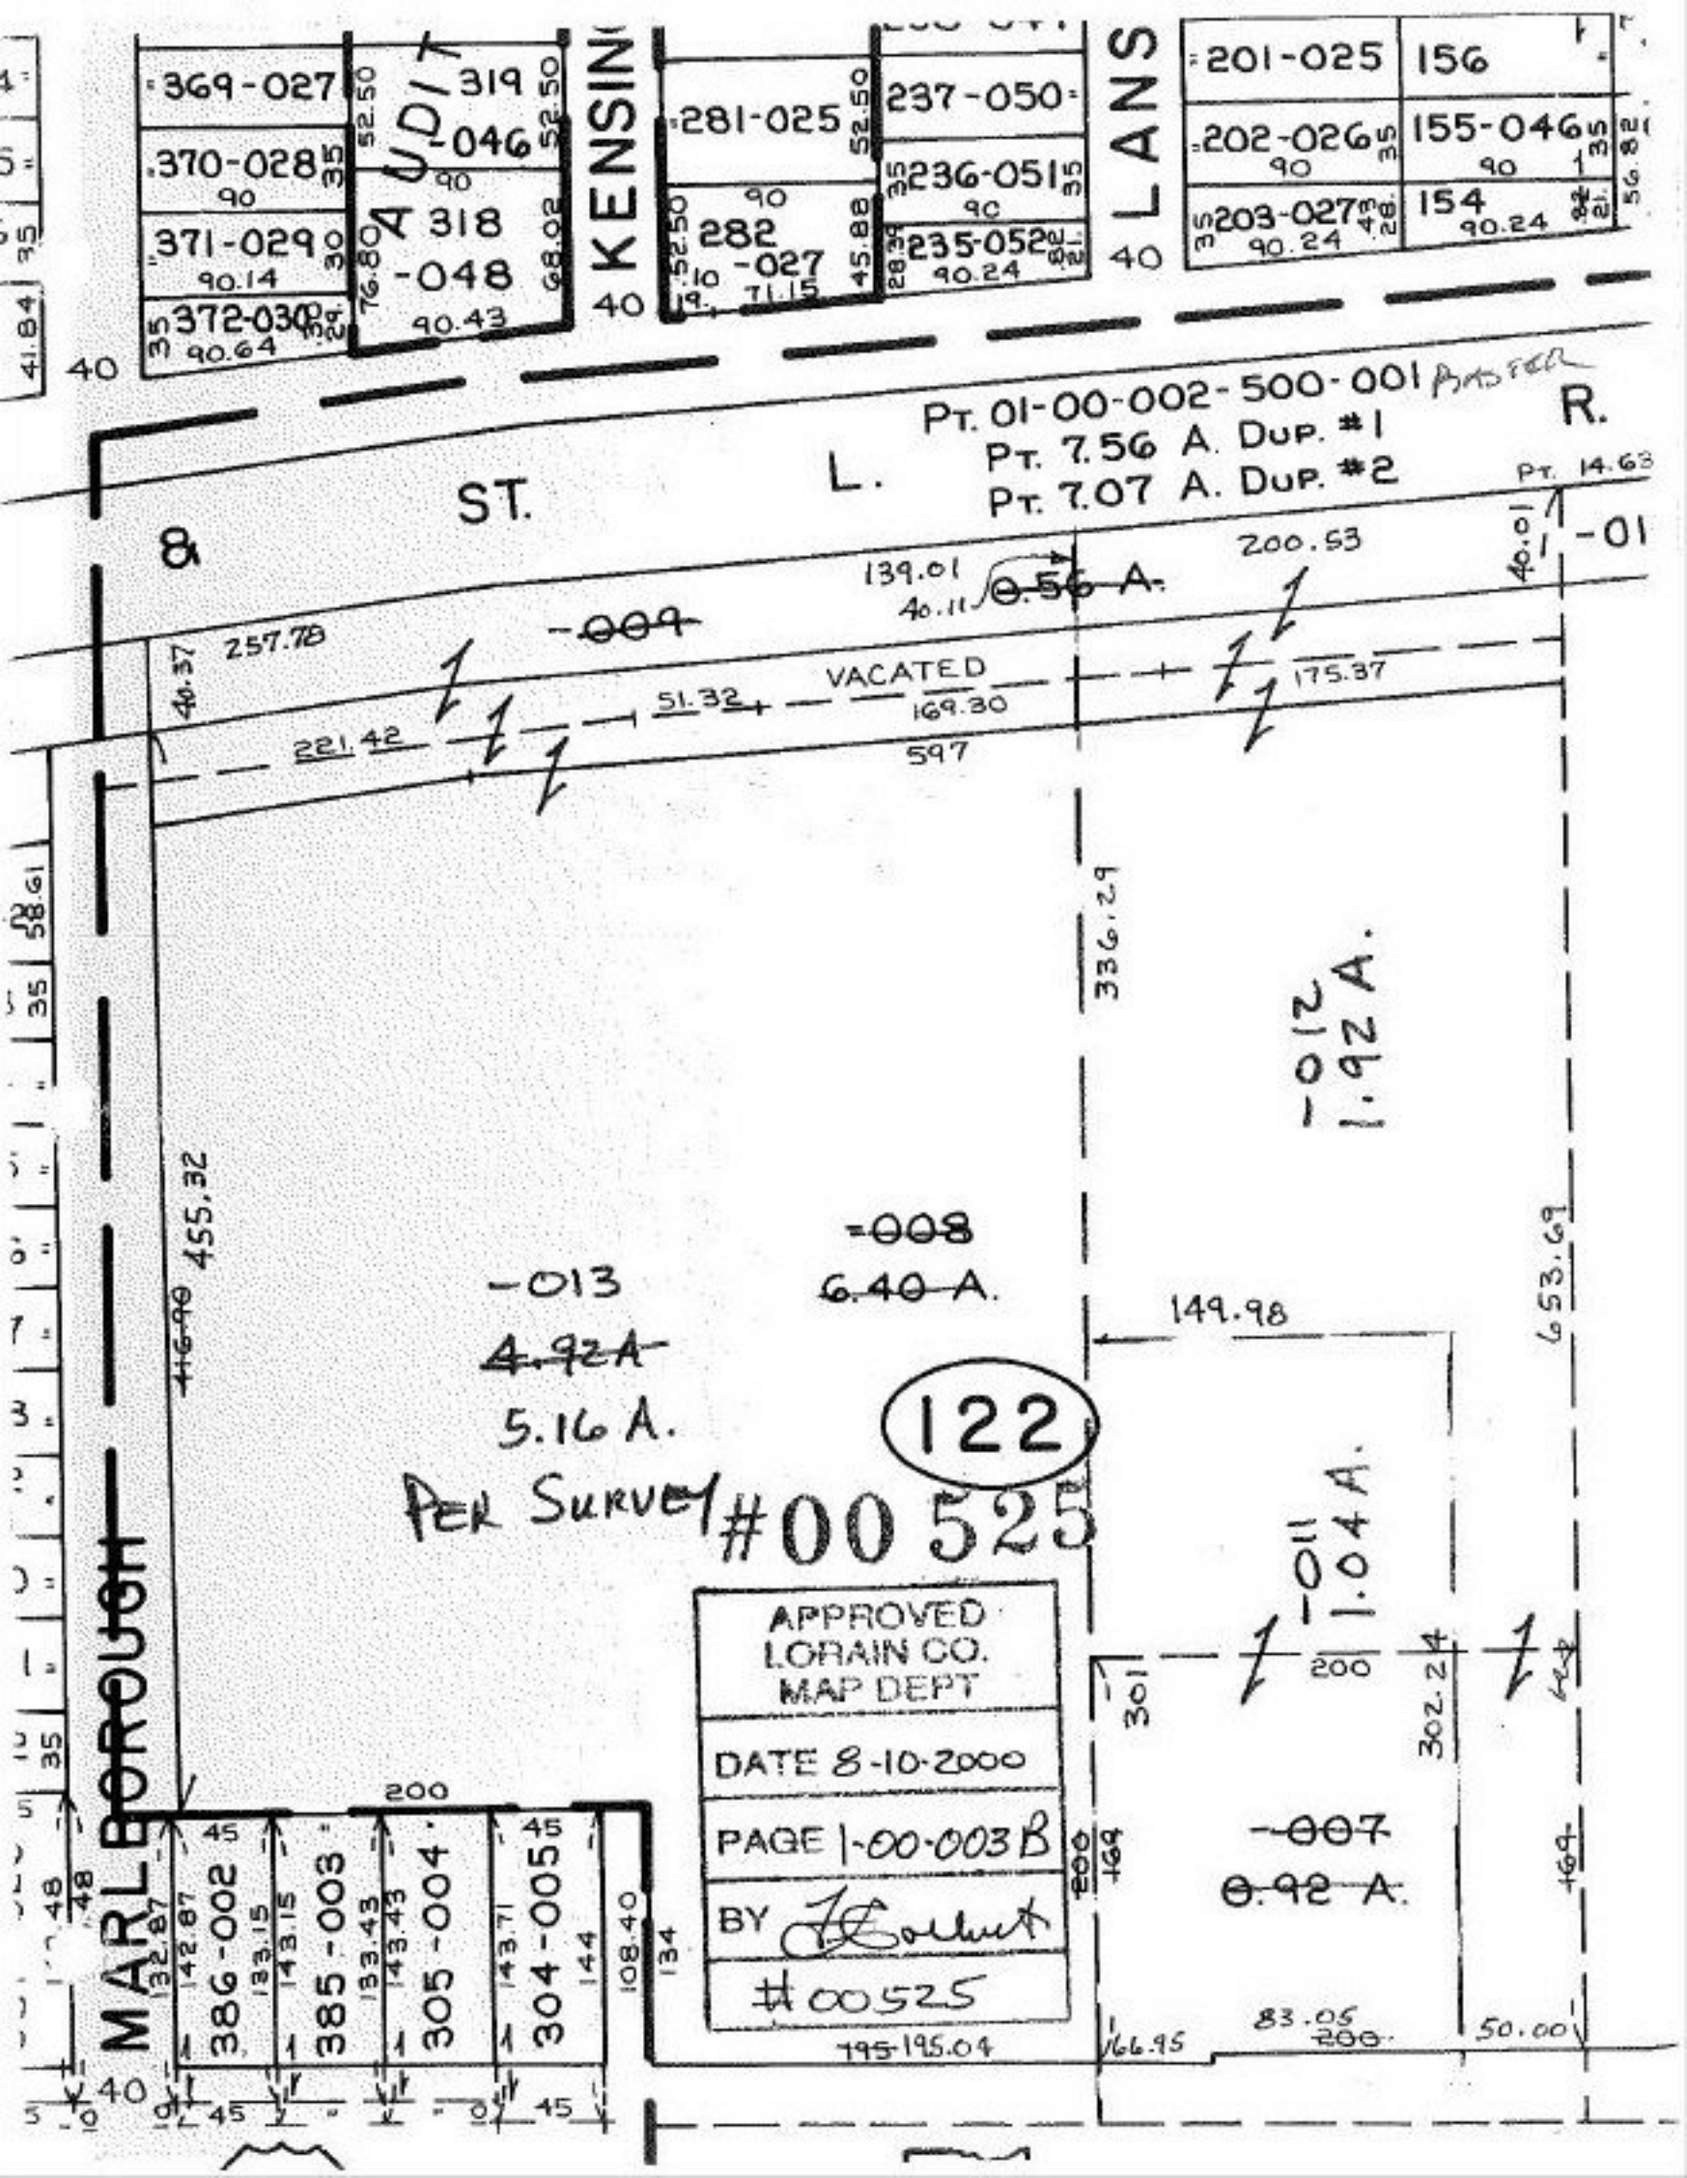

369-027
370-028
371-029
372-030
AUDIT
319
-046
318
-048
KENSING
281-025
282
-027
237-050
236-051
235-052
LANS
201-025
202-026
203-027
156
155-046
154
PT. 01-00-002-500-001 BASTER
PT. 7.56 A. DUP. #1
PT. 7.07 A. DUP. #2
ST.
L.
R.
PT. 14.63
-01
-009
0.56 A.
VACATED
-012
1.92 A.
-008
6.40 A.
-013
4.92 A
5.16 A.
PER SURVEY #00525
122
-011
1.04 A.
-007
0.92 A.
MARLBOROUGH
386-002
385-003
305-004
304-005
APPROVED
LORAIN CO.
MAP DEPT
DATE 8-10-2000
PAGE 1-00-003 B
BY
#00525