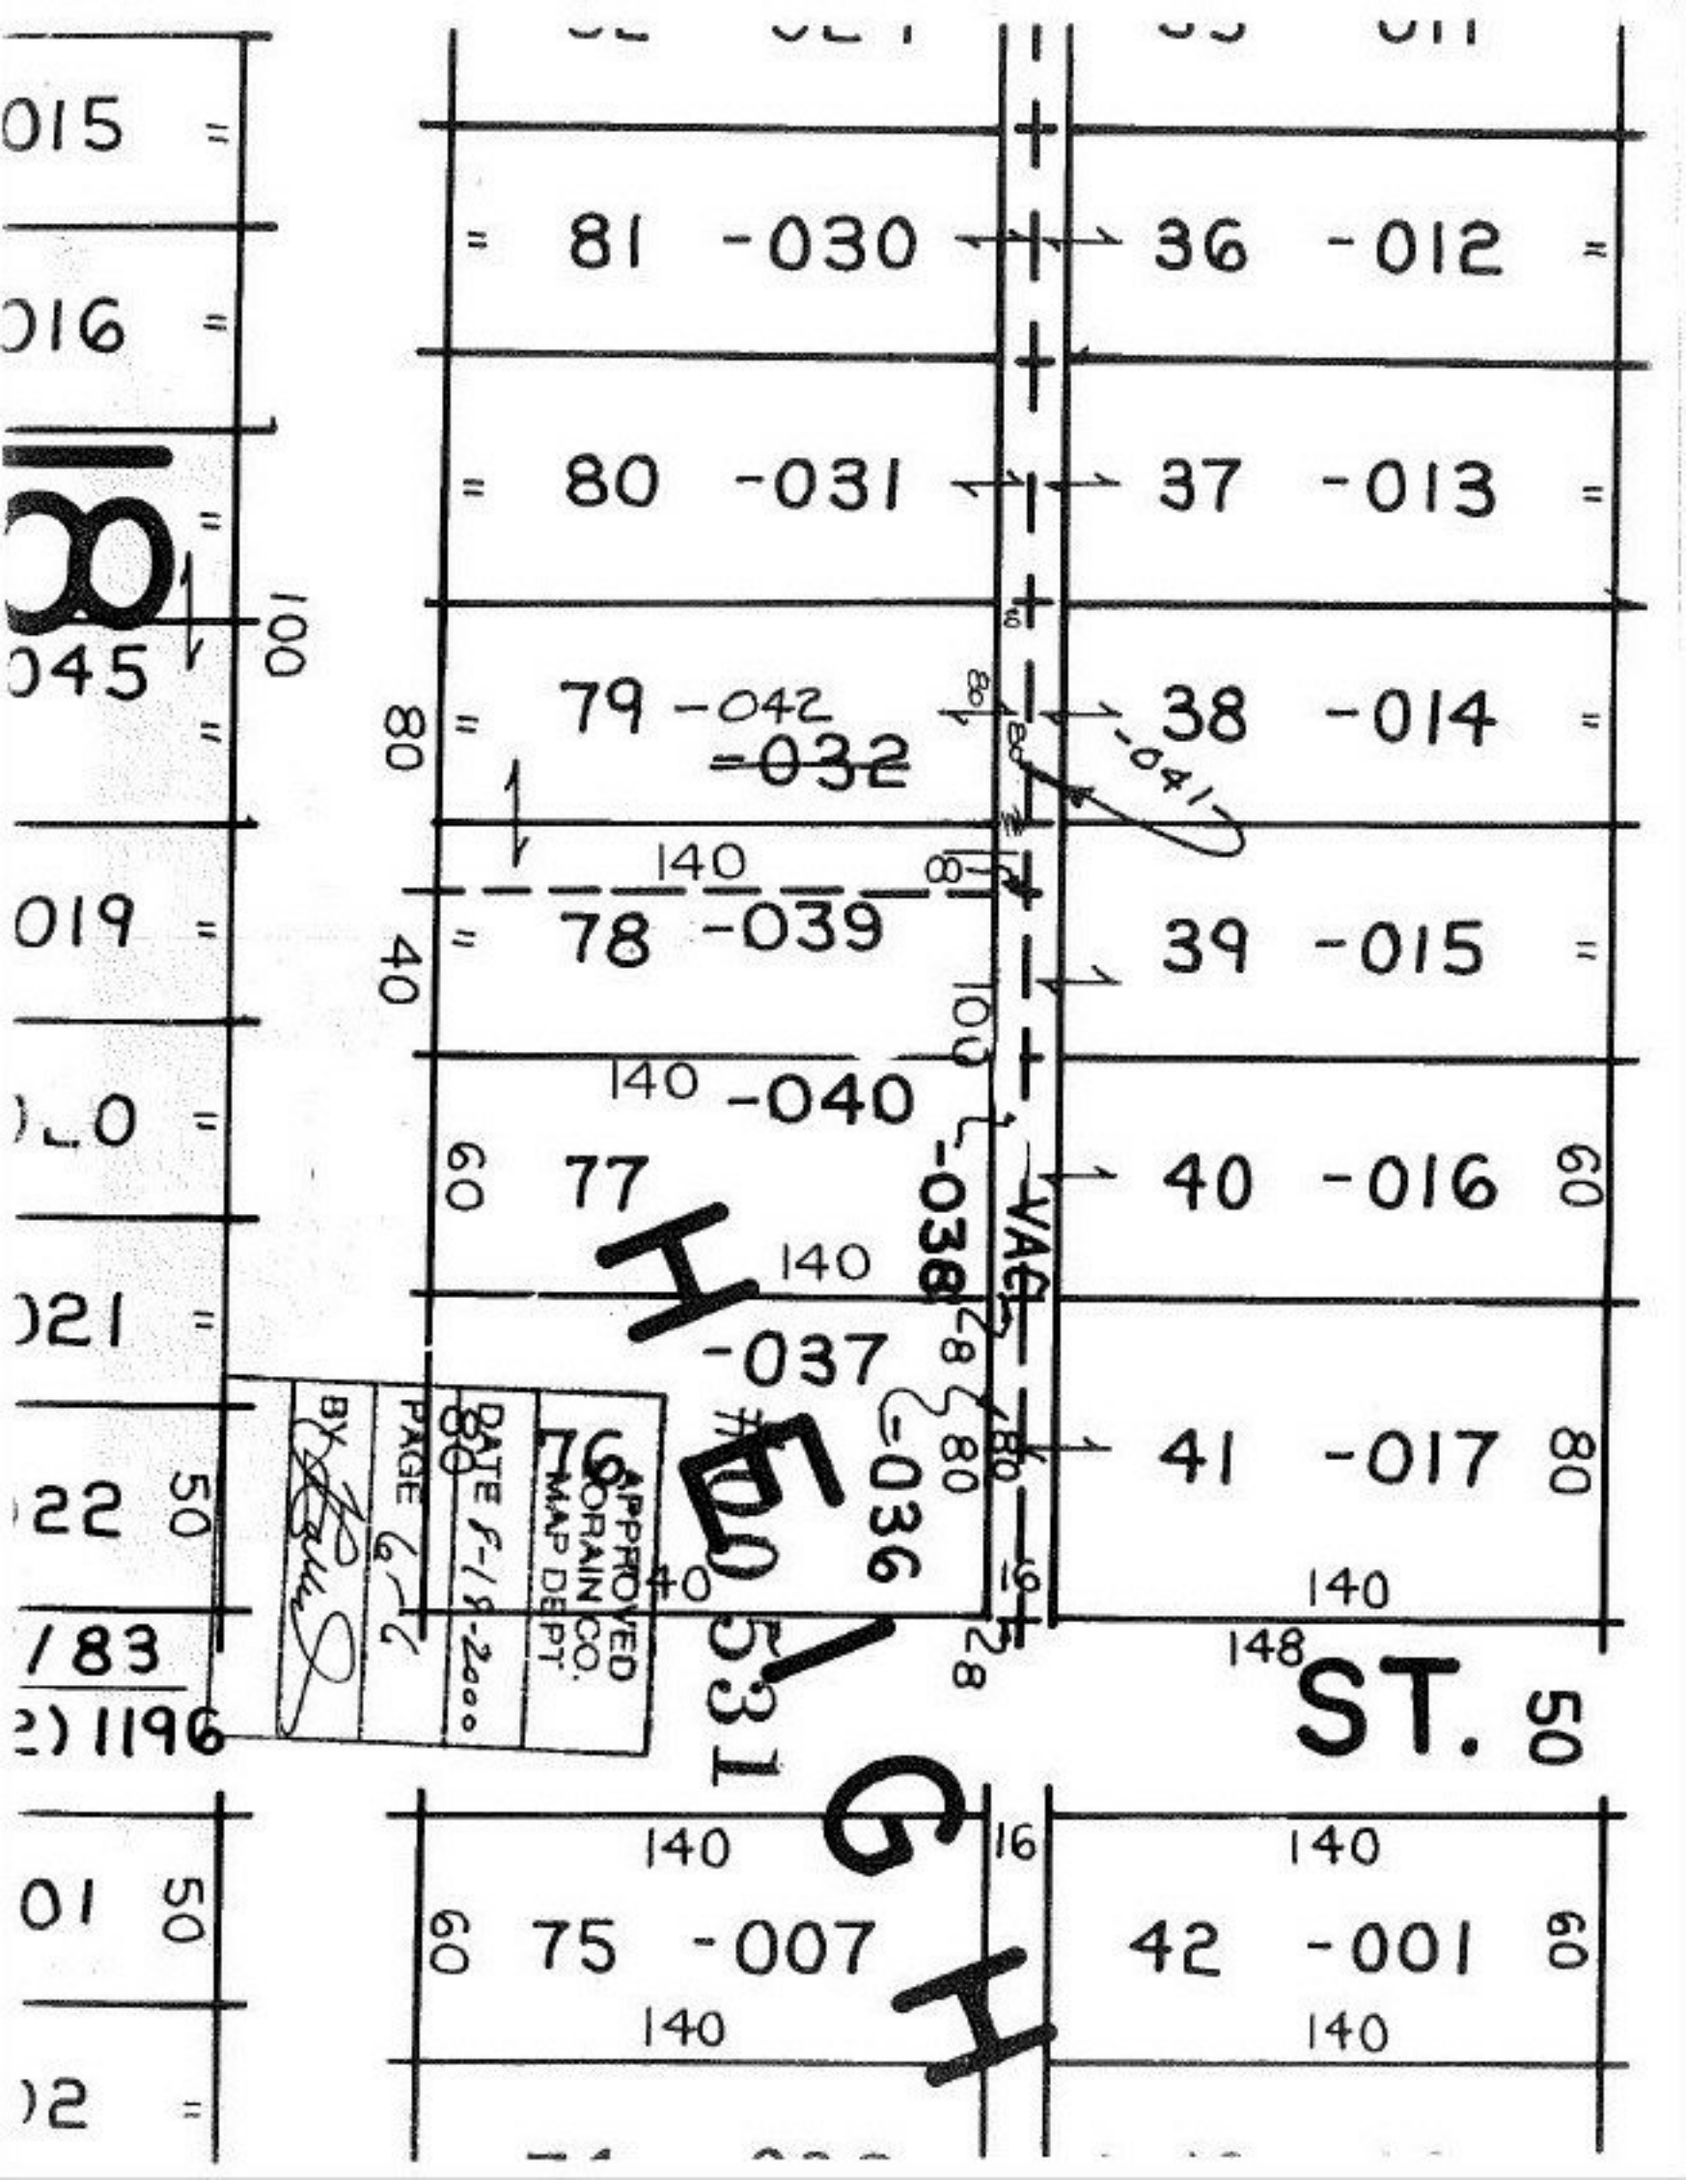

015
016
045
019
021
22
/83
2) 1196
01
02
81 -030
36 -012
80 -031
37 -013
79 -042
-032
38 -014
-041
78 -039
39 -015
-040
77
40 -016
-038
VAC
-037
76
41 -017
-036
ST. 50
75 -007
42 -001
140
148
100
80
40
60
50
16
28
APPROVED
DORAIN CO.
MAP DEPT
DATE 8-18-2000
PAGE 6-6
BY
HEIGHT