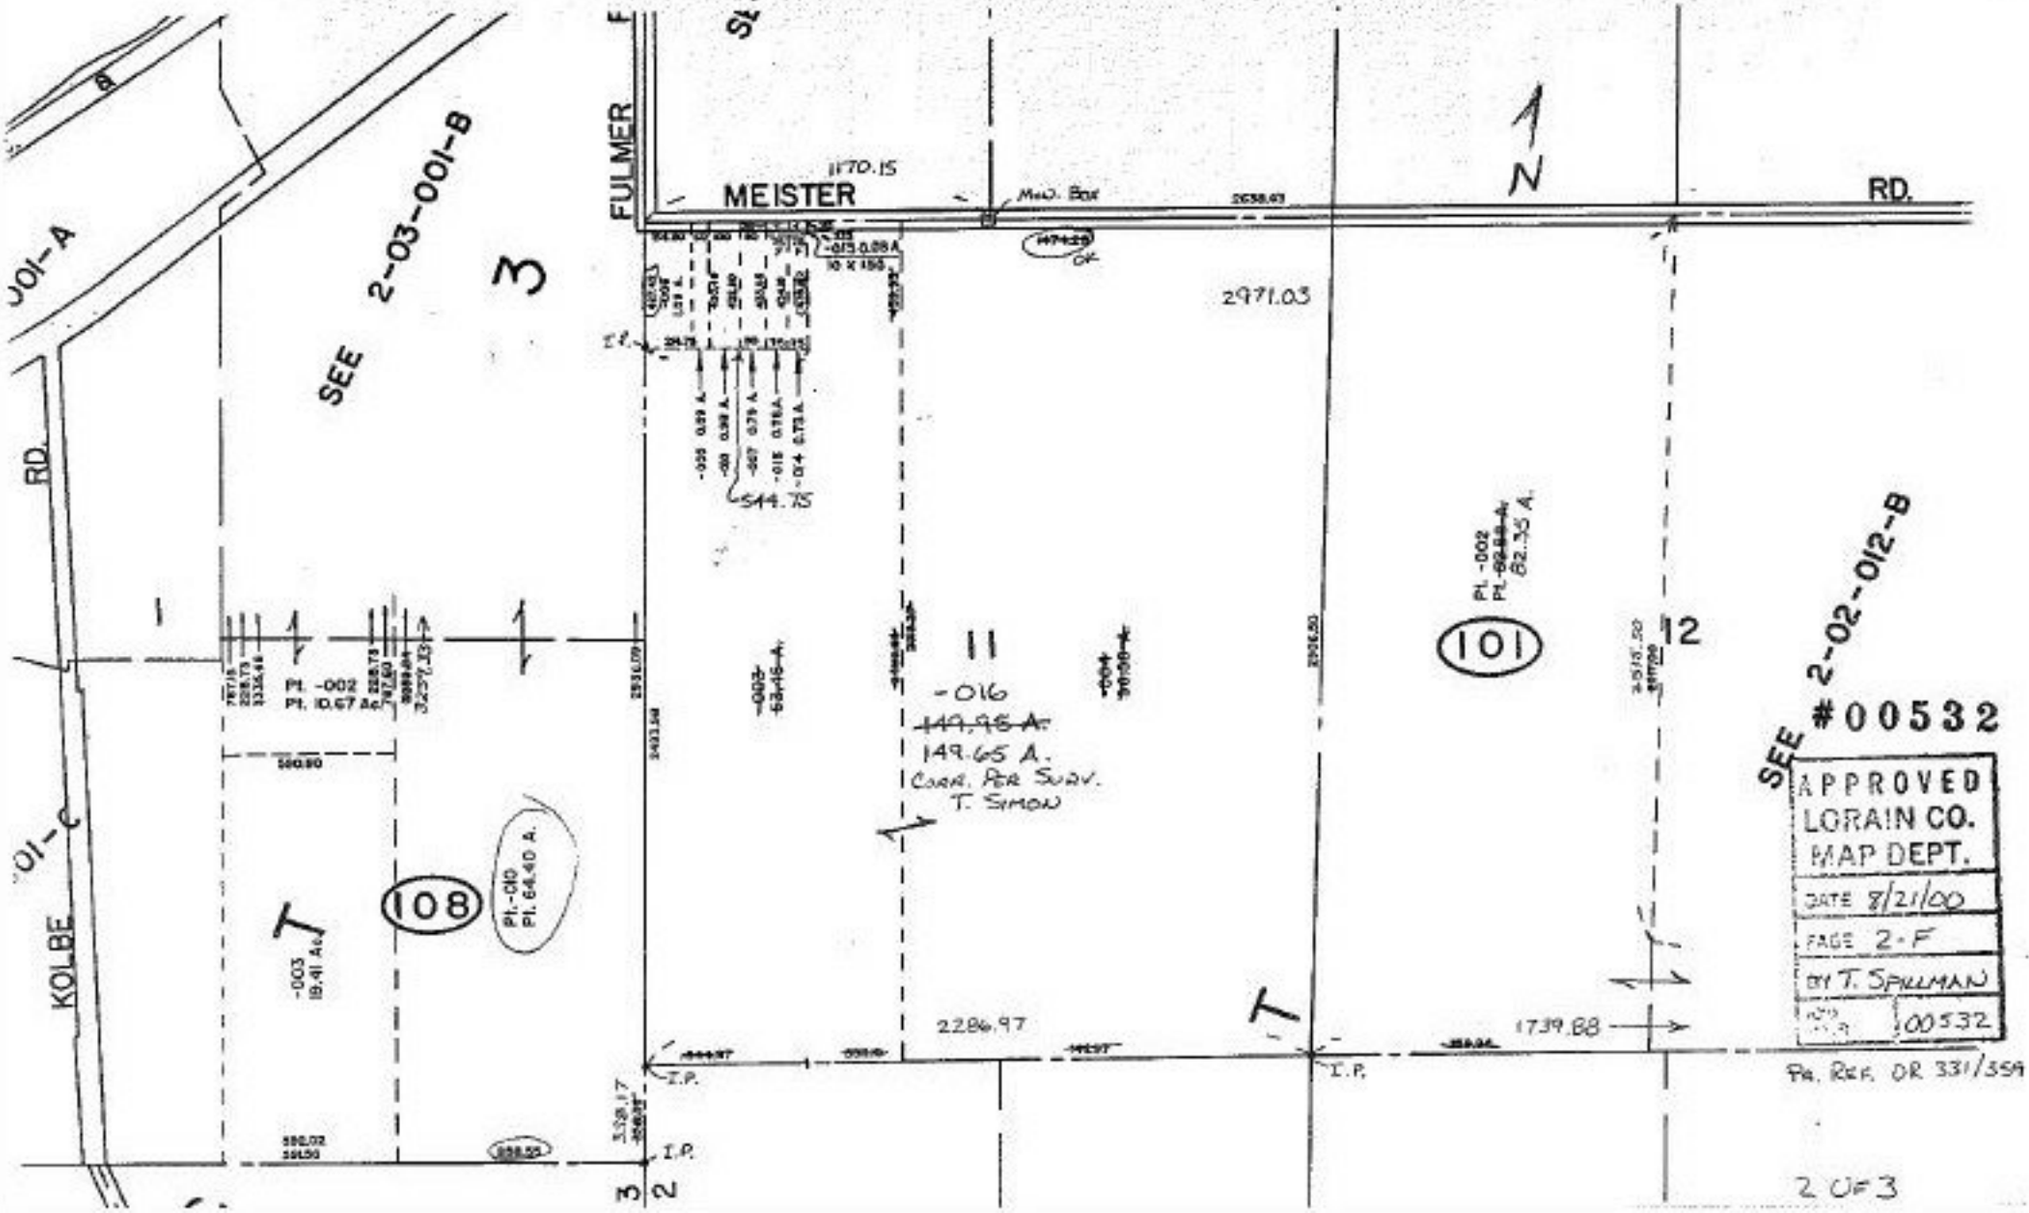
FULMER
MEISTER
RD.
1170.15
2971.03
544.75
SEE 2-03-001-B
RD.
KOLBE
001-A
001-C
SEE 2-02-012-B
SEE #00532
Pt. -002
Pt. 10.67 A.
-003
19.41 Ac.
108
Pt. -010
Pt. 64.40 A.
-016
149.95 Ac.
149.65 A.
Corr. Per Surv.
T. Simon
Pt. -002
82.35 A.
101
11
12
2284.97
1739.88
I.P.
Pa. Rec. OR 331/359
APPROVED
LORAIN CO.
MAP DEPT.
DATE 8/21/00
PAGE 2-F
BY T. SPILLMAN
00532