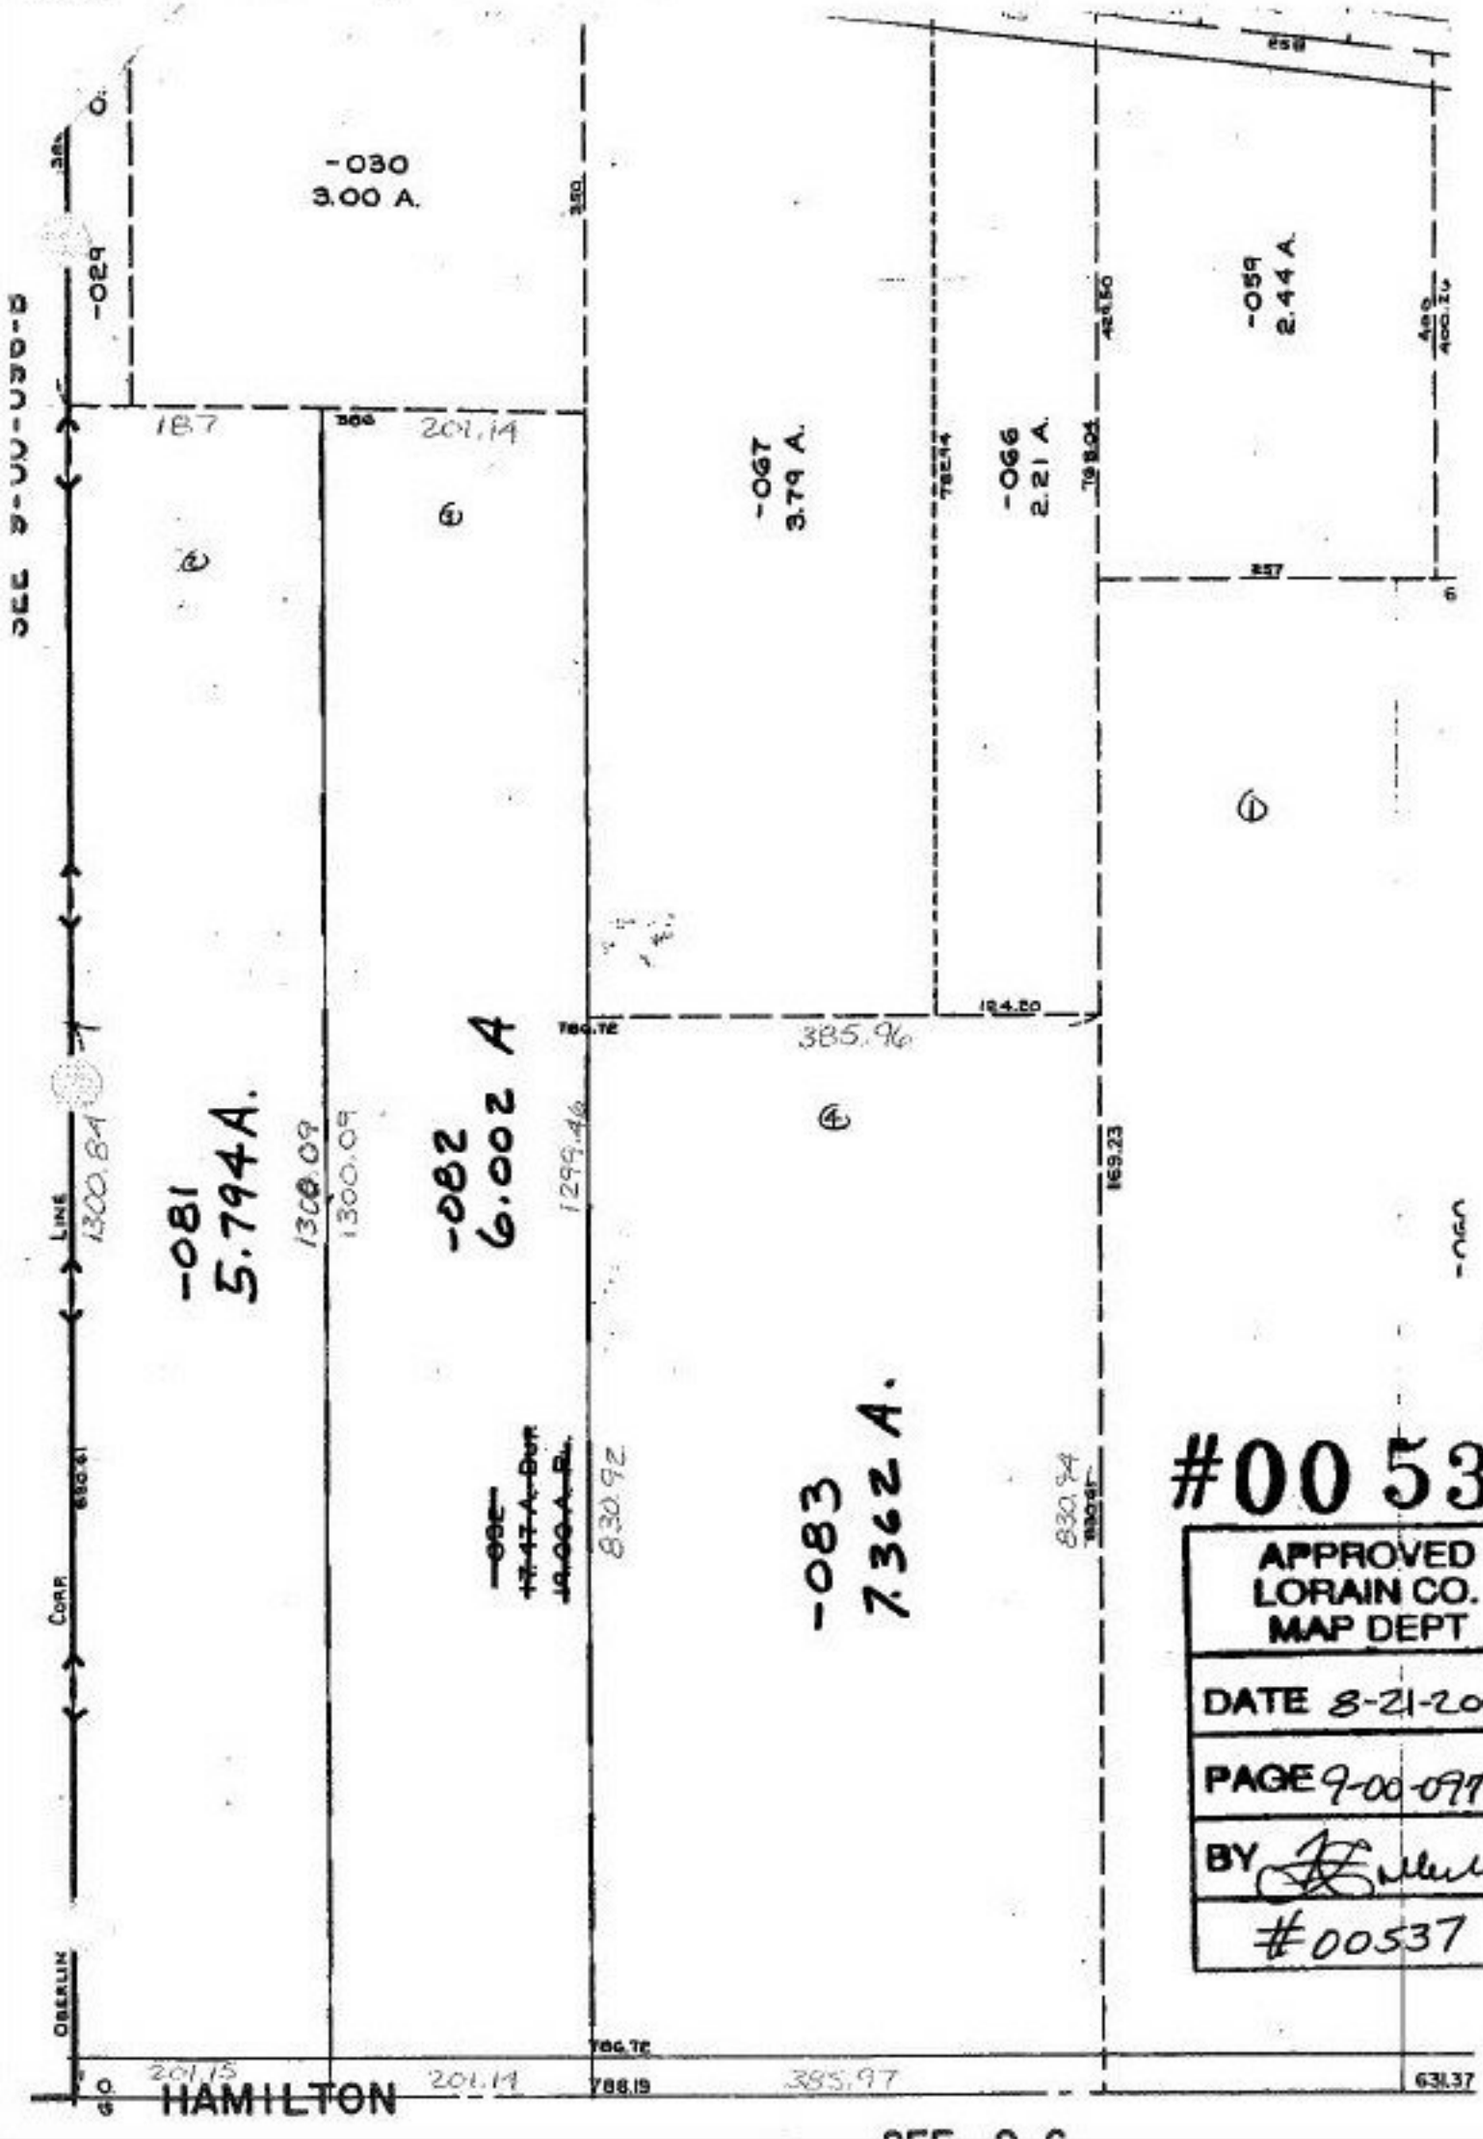
-030
3.00 A.
-029
-067
3.79 A.
-066
2.21 A.
-059
2.44 A.
-081
5.794A.
-082
6.002 A
-083
7.362 A.
-080
SEE 9-00-030-B
LINE
CORP.
OBERLIN
HAMILTON
187
200.14
385.96
1300.84
1300.09
1299.46
830.92
830.94
169.23
201.15
385.97
631.37
786.19
786.72
#00537
APPROVED
LORAIN CO.
MAP DEPT
DATE 8-21-2000
PAGE 9-00-097 A
BY
#00537