RASTER

PARENT PARCEL: 15-00-048-000-001, -002

CHILD PARCEL: 15-00-048-000-012 THRU -018

STARTING POINT: CENTERLINE OF WHEELER RD. & WAKEMAN-LAGRANGE RD.

NO. 00538

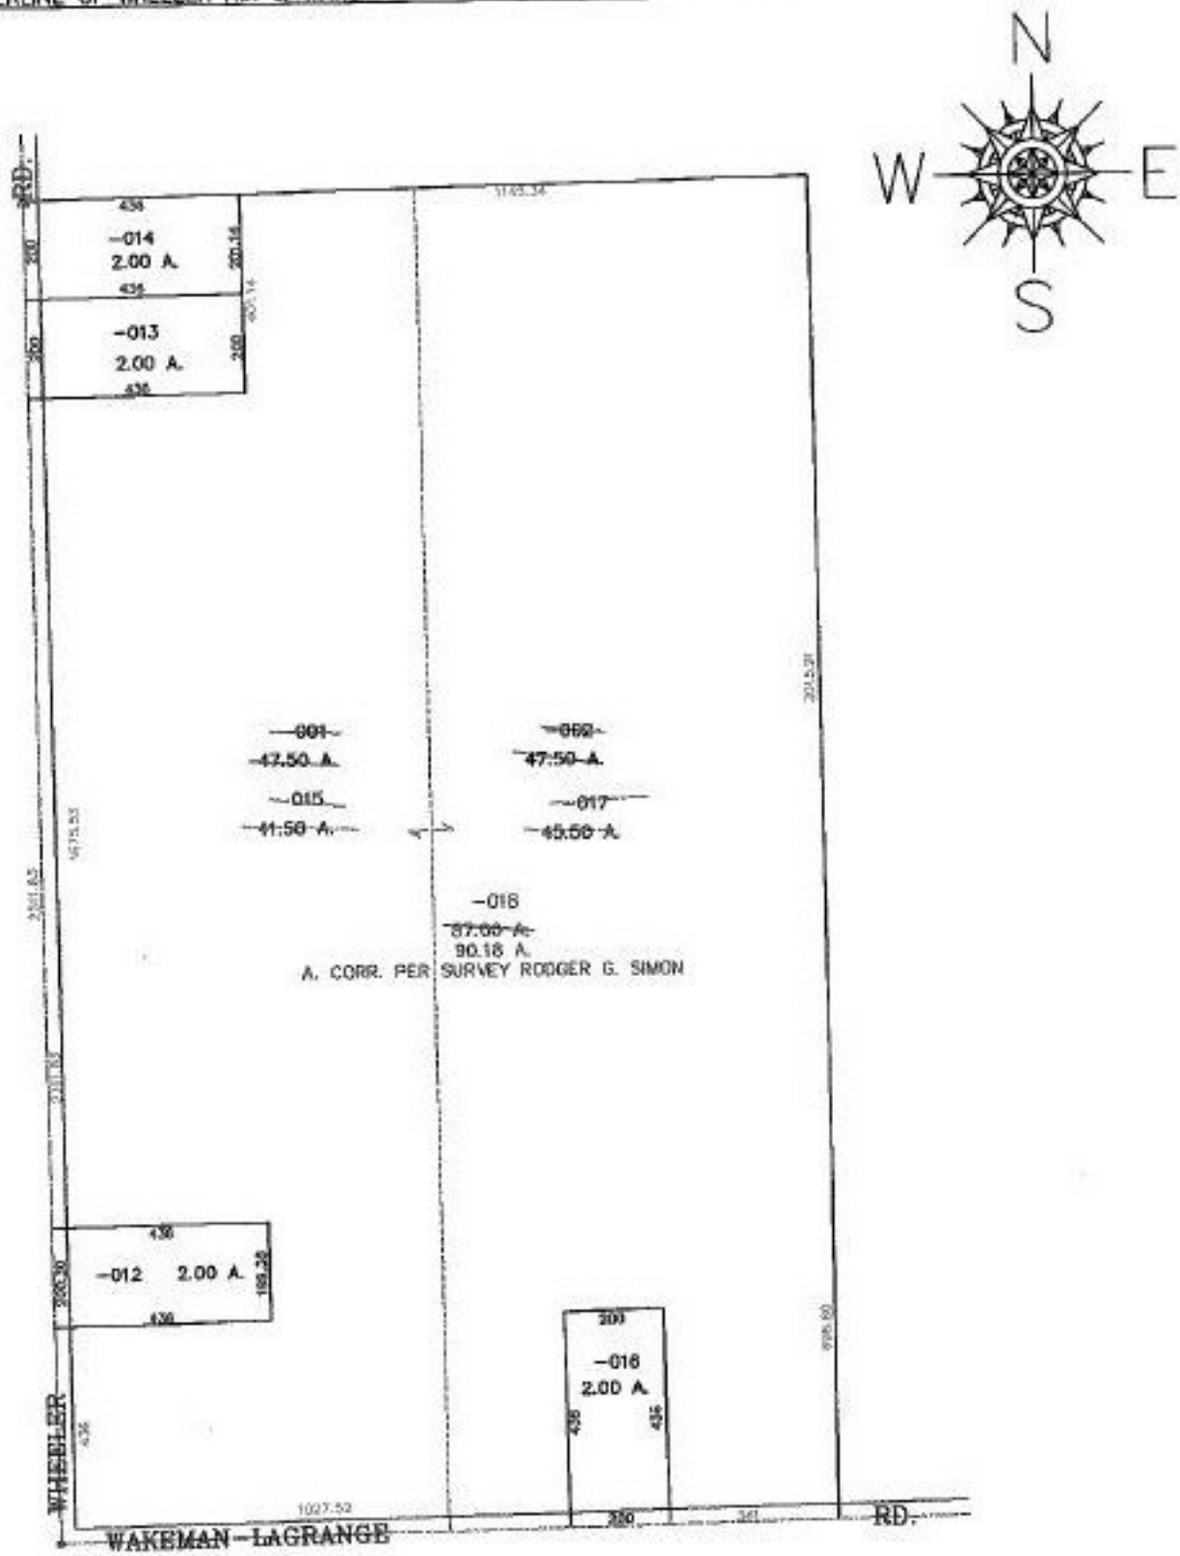

SPLITS/DEEDS PROCESSED

LORAIN COUNTY TAX MAP DEPARTMENT
226 MIDDLE AVE. ELYRIA, OHIO

SURVEYED BY: RODGER G. SIMON

CLOSURE: 0.02 : 10,000

MAP PAGE(S): 15-0

APPROVED BY: JAH DATE: 8-25-00

SCALE: 1"= 400 PRIOR INSTRUMENT: 20000666324