RASTER

PARENT PARCEL: 07-00-042-000-006 & 008
CHILD PARCEL: 07-00-042-000-010 THRU -012
STARTING POINT: CENTERLINES OF BARRES RD. & OTTEN RD.

NO. 00551

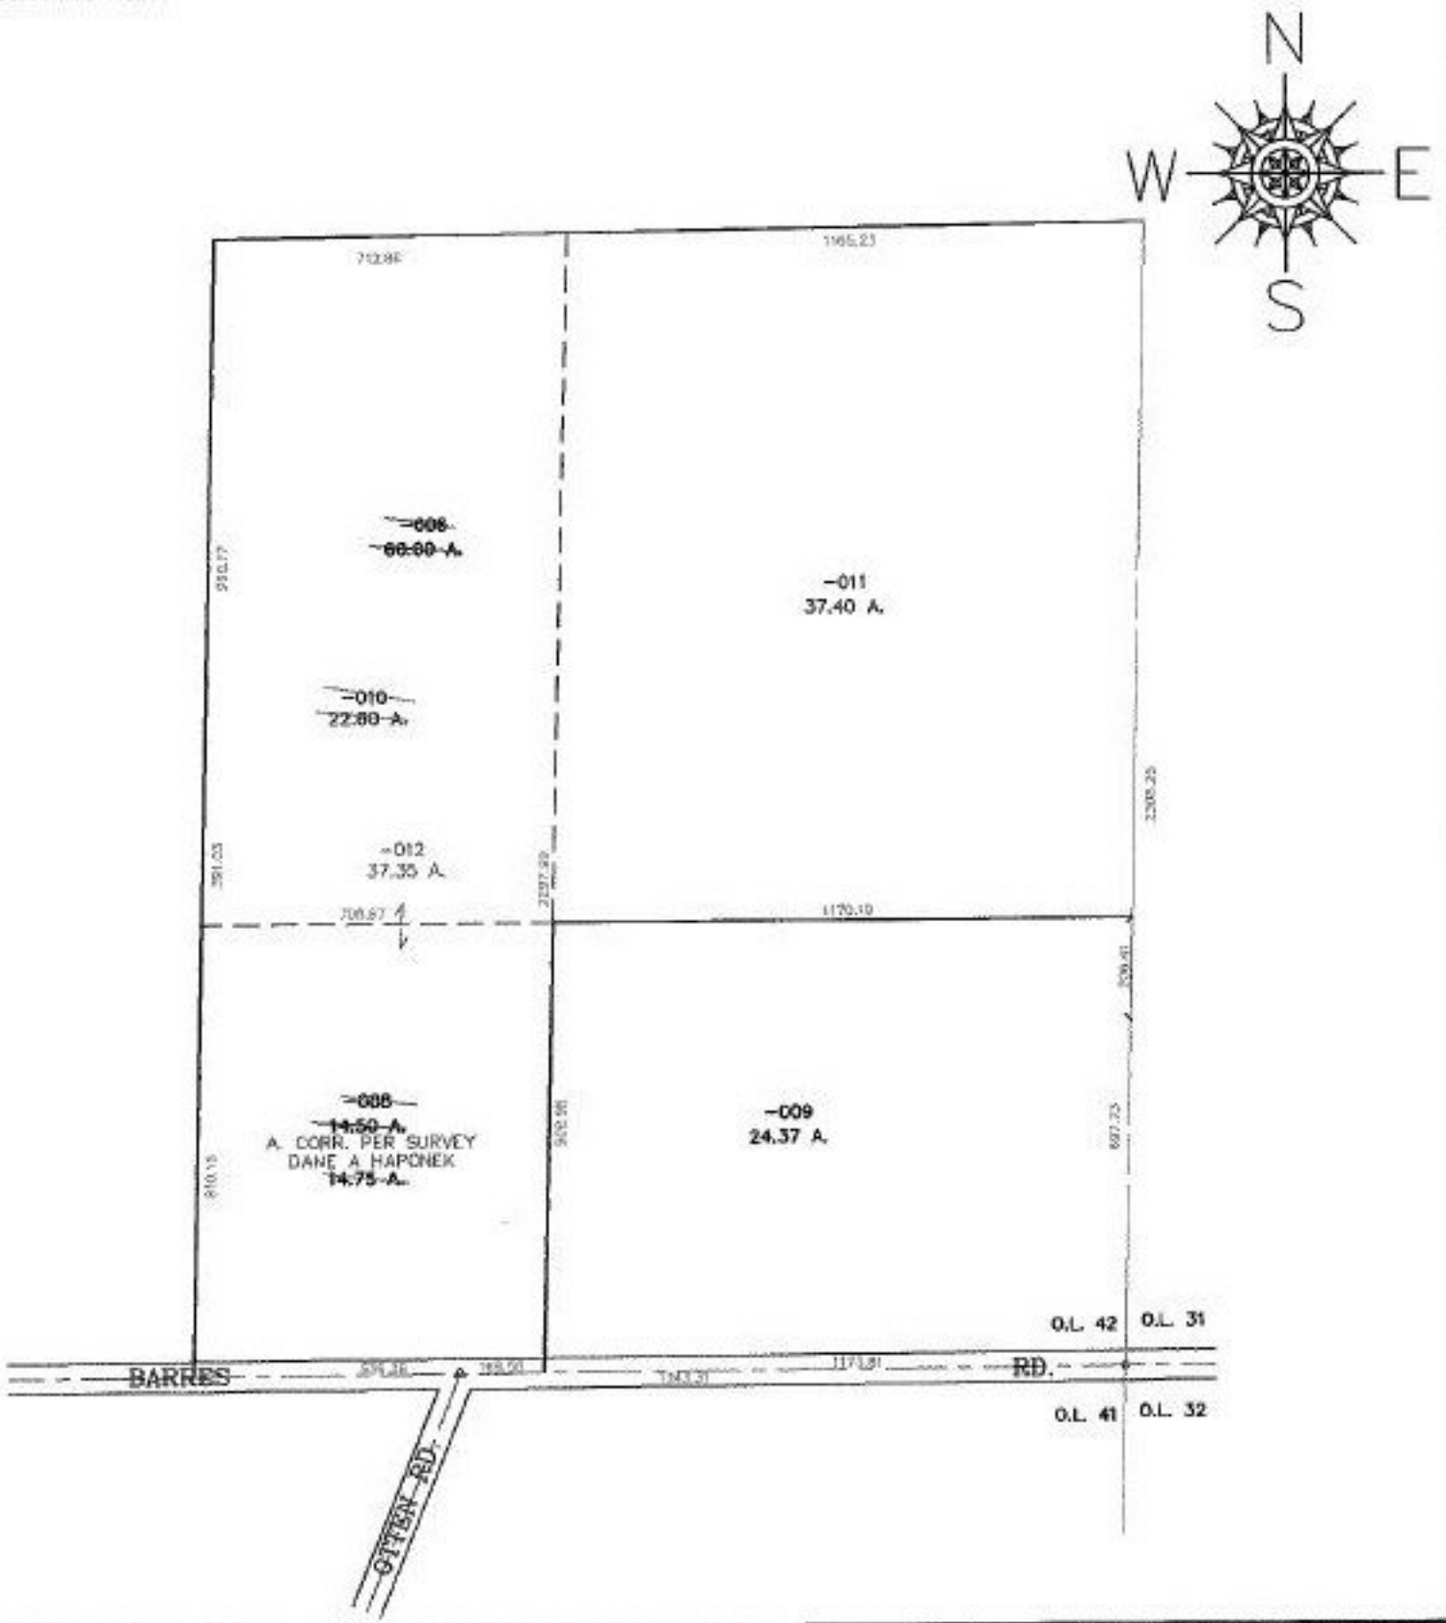

SPLITS/DEEDS PROCESSED
LORAIN COUNTY TAX MAP DEPARTMENT
226 MIDDLE AVE. ELYRIA, OHIO

SURVEYED BY: DANE A. HAPONEK
CLOSURE: 0.01 : 10,000
MAP PAGE(S): 7-A
APPROVED BY: JAH DATE: 8-29-00
SCALE: 1"= 400 PRIOR INSTRUMENT: 990644596