RASTER

PARENT PARCEL: 19-05-006-000-018 & -015
CHILD PARCEL: 19-05-006-000-027 THRU -029
STARTING POINT: MON. BOX , CL OF INDIAN HOLLOW RD. & NORTH LINE OF O.L. 6

NO. 00556

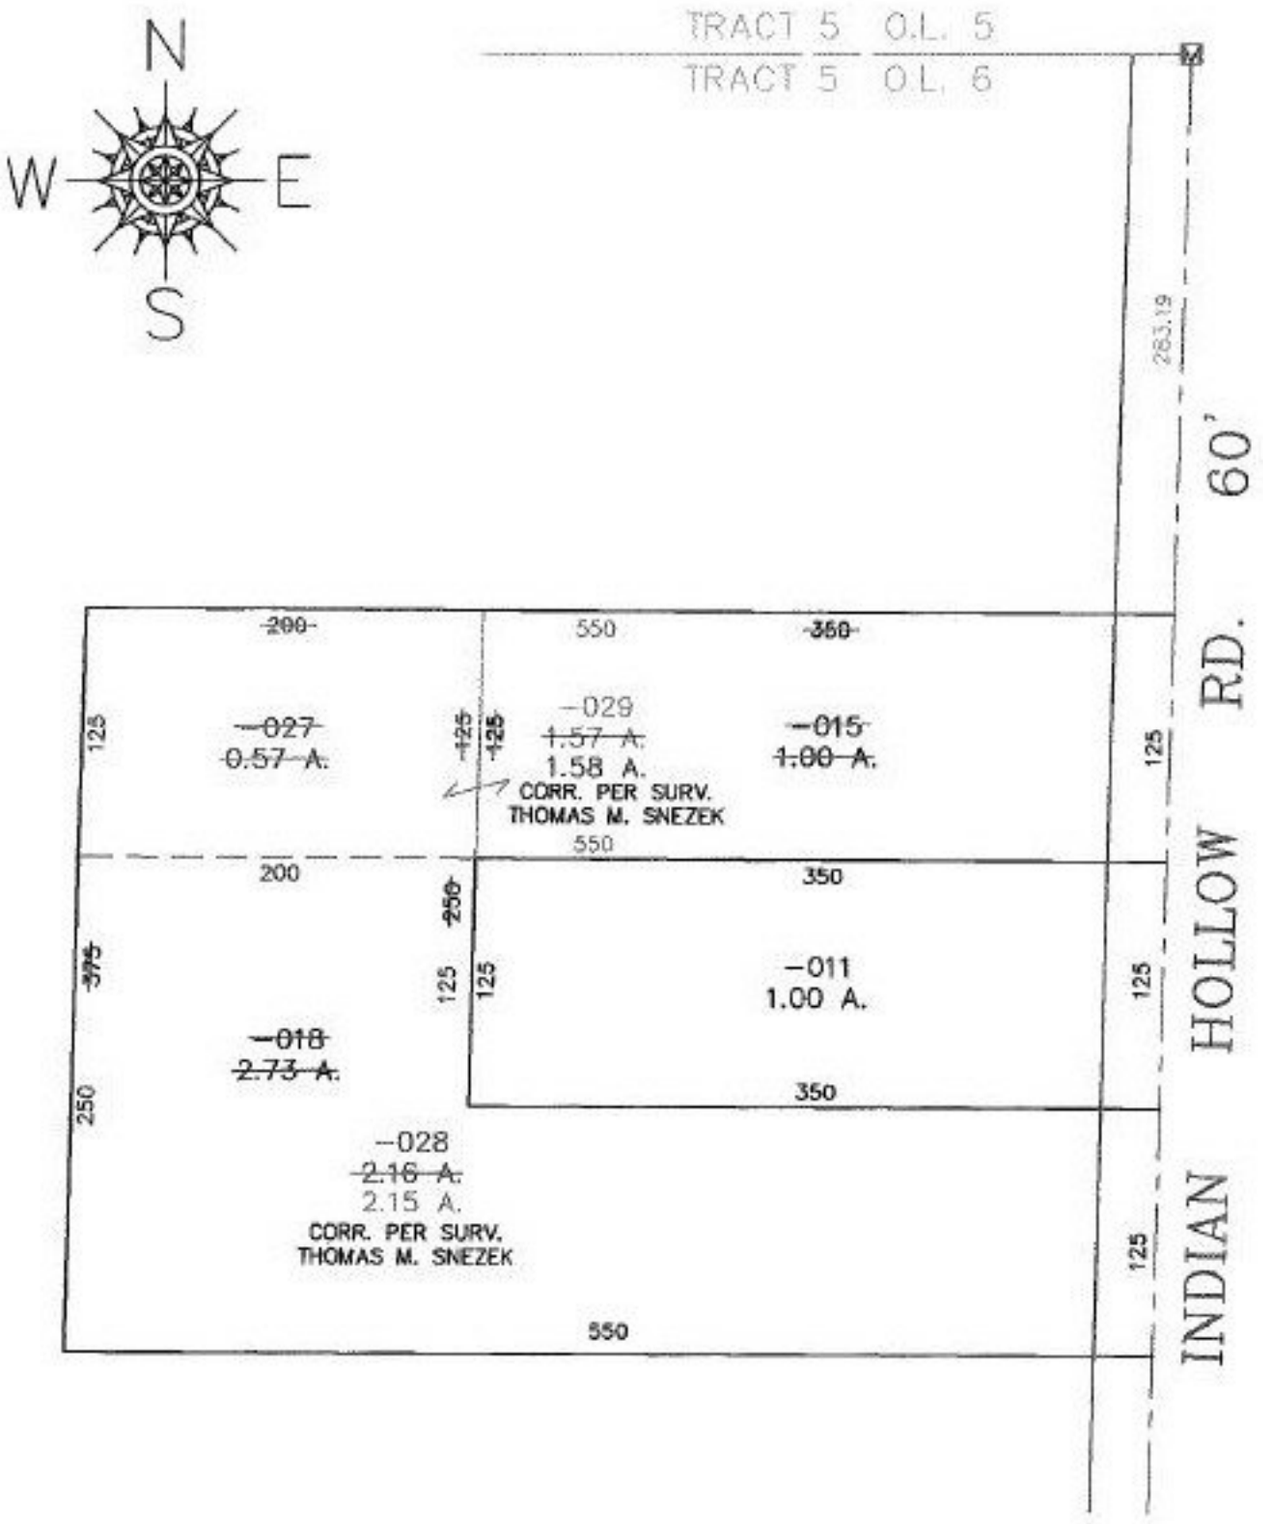

SPLITS/DEEDS PROCESSED

LORAIN COUNTY TAX MAP DEPARTMENT
226 MIDDLE AVE. ELYRIA, OHIO

SURVEYED BY: THOMAS M. SNEZEK
CLOSURE: 0.00 : 10.000
MAP PAGE(S): 19-C
APPROVED BY: T. SPILLMAN DATE: 08/30/00
SCALE: 1" = 100 PRIOR INSTRUMENT: OR 1066/756