RASTER

PARENT PARCEL: 13-11-017-000-002, -003, -015, -016, & -021
CHILD PARCEL: 13-11-017-000-026 THRU -033
STARTING POINT: CL OF HAIGH RD. & EAST LINE OF O.L. 17

NO. 00566

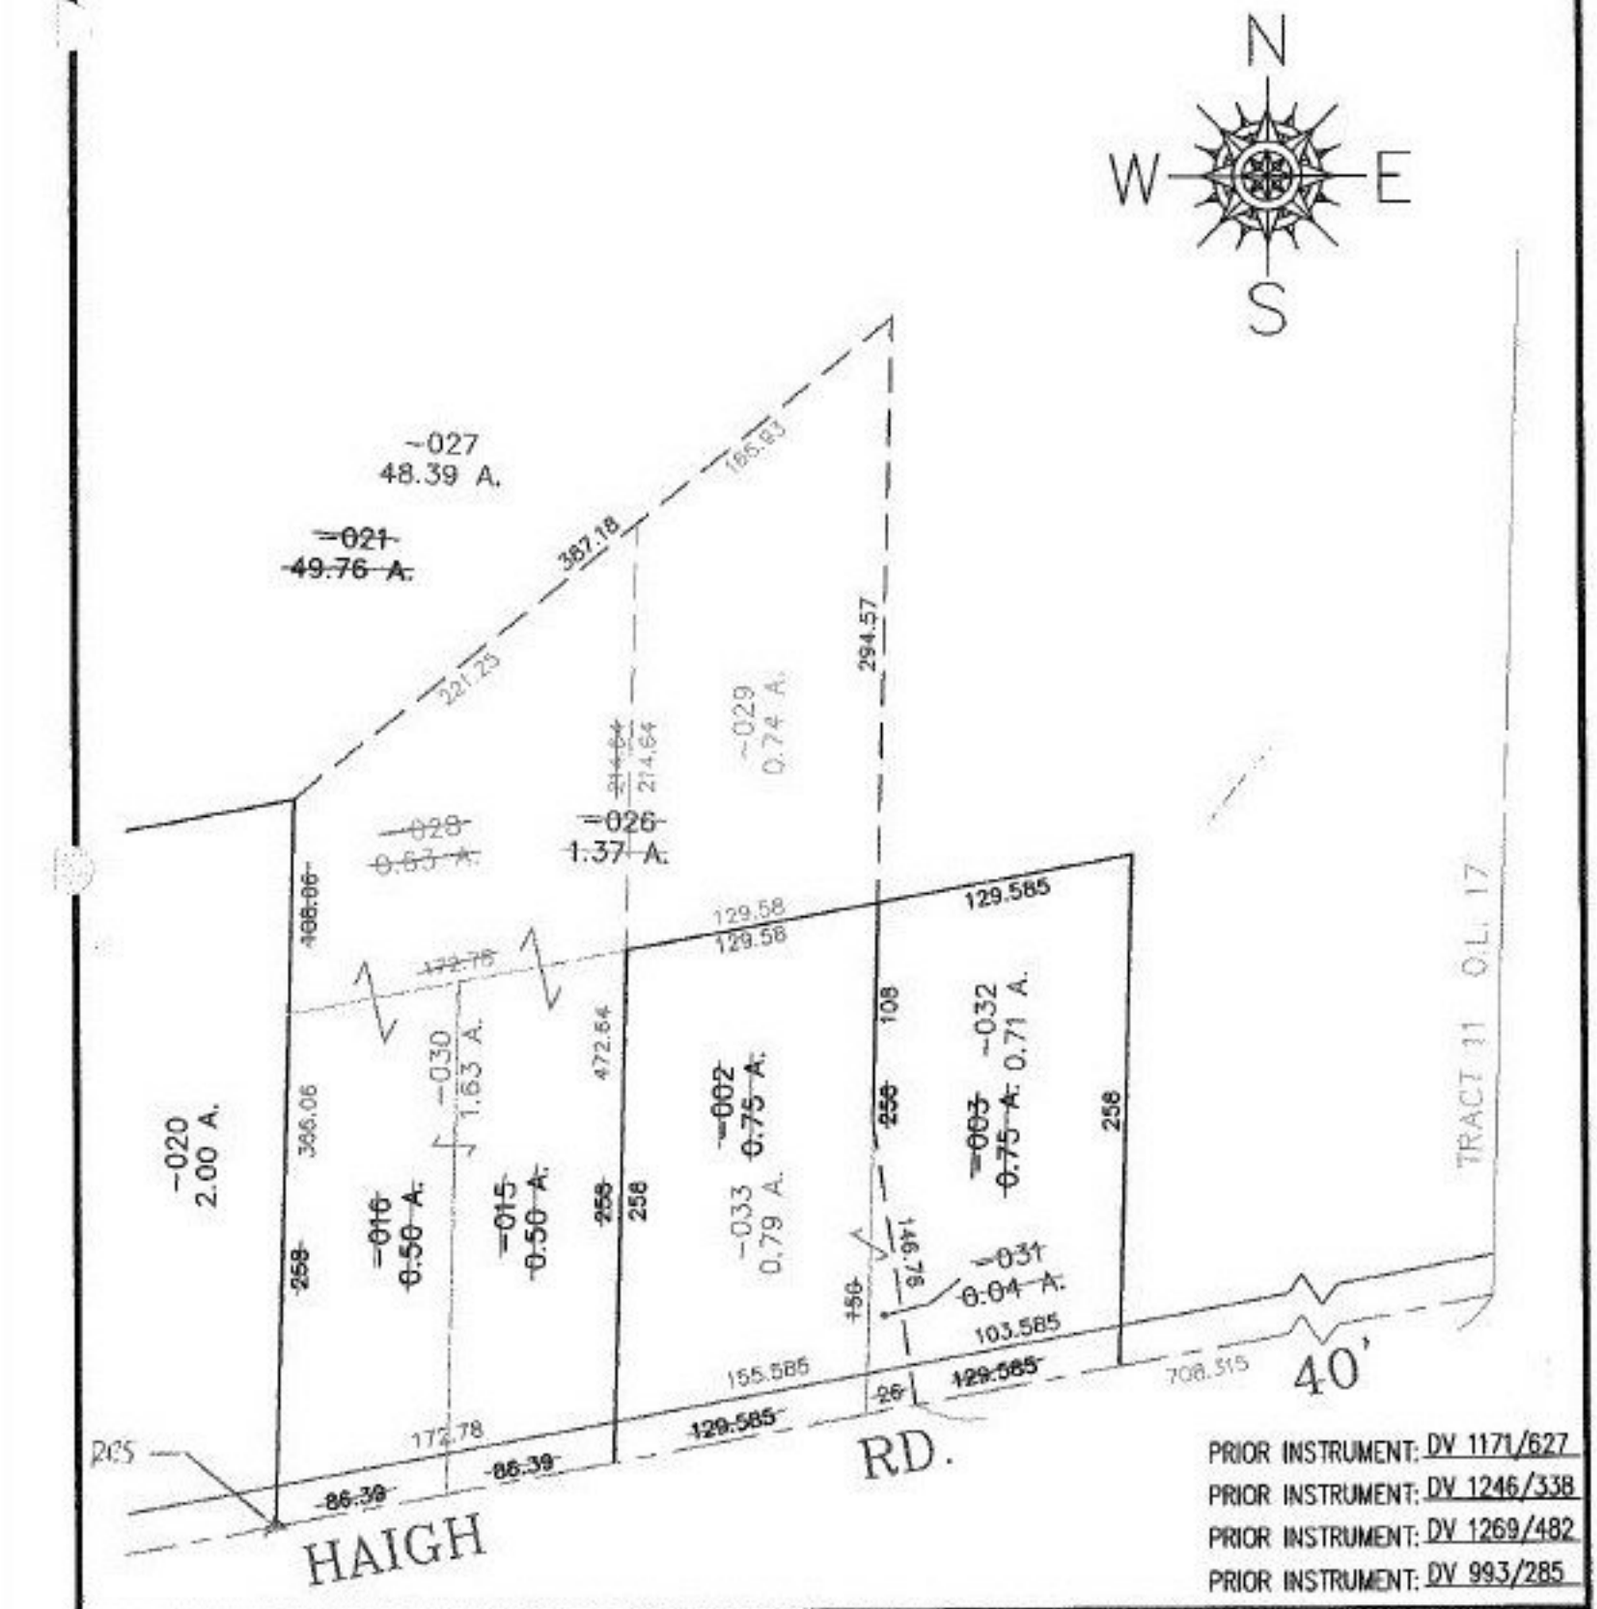

PRIOR INSTRUMENT: DV 1171/627
PRIOR INSTRUMENT: DV 1246/338
PRIOR INSTRUMENT: DV 1269/482
PRIOR INSTRUMENT: DV 993/285

SPLITS/DEEDS PROCESSED

LORAIN COUNTY TAX MAP DEPARTMENT
226 MIDDLE AVE. ELYRIA, OHIO

SURVEYED BY: SUSAN L. EICHHORN
CLOSURE: 0.01 : 10.000
MAP PAGE(S): 13-11-017
APPROVED BY: TJS DATE: 09/27/00
SCALE: 1" = 100