RASTER

PARENT PARCEL: 08-15-011-000-002, -004
CHILD PARCEL: 08-15-011-000-012, -013-, -014
STARTING POINT: CENTERLINE OF GARFIELD RD.& O.L. 11

NO. 00572

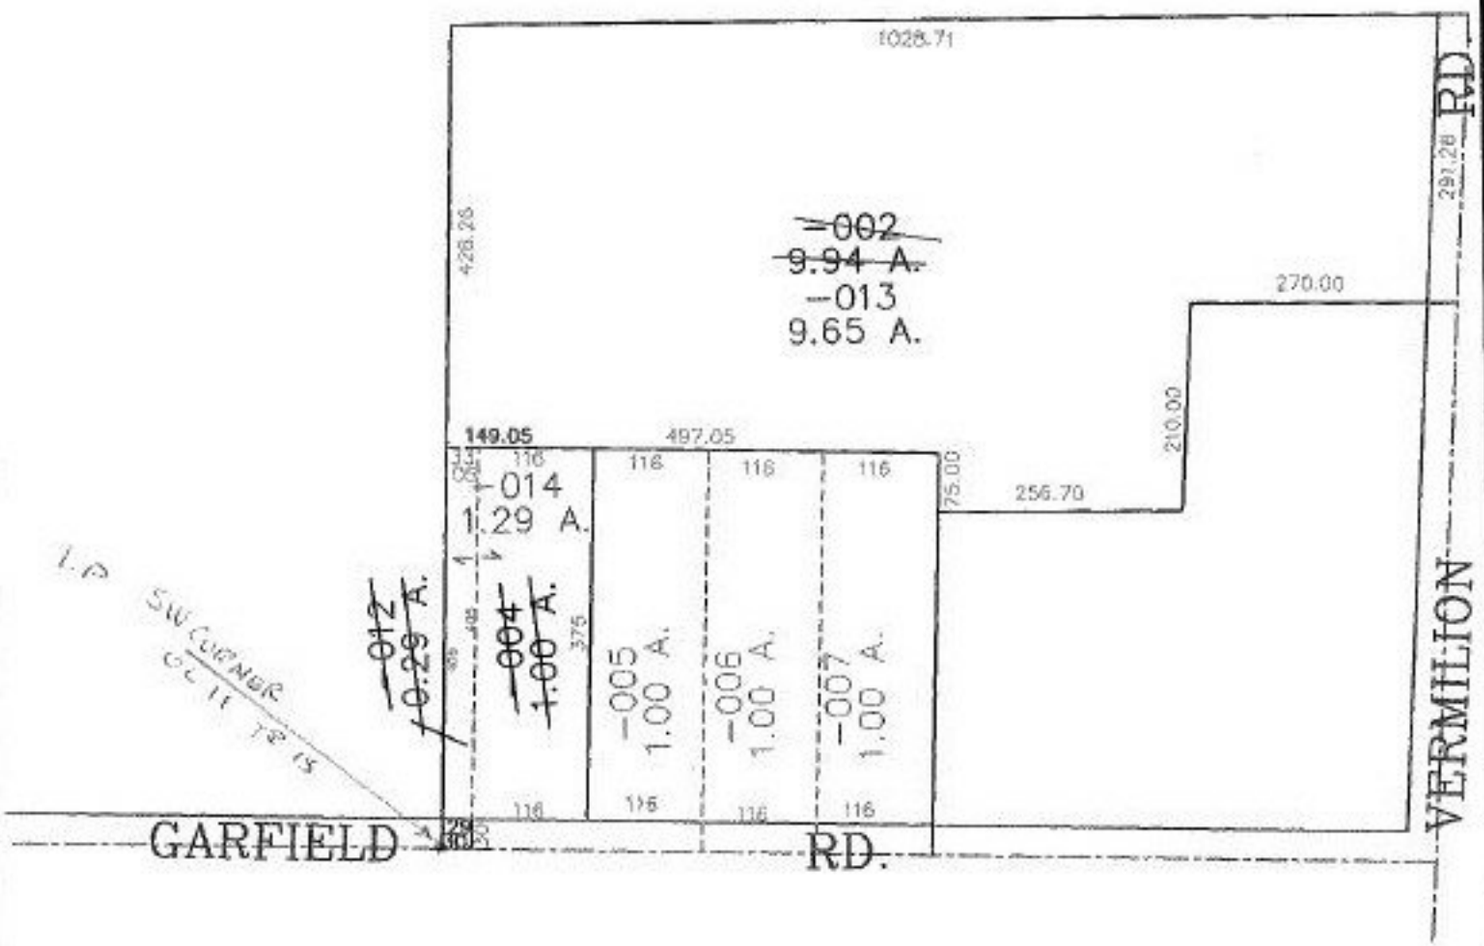

SPLITS/DEEDS PROCESSED
LORAIN COUNTY TAX MAP DEPARTMENT
226 MIDDLE AVE. ELYRIA, OHIO

SURVEYED BY: CHARLES P. WARYU
CLOSURE: 0.08:10,000
MAP PAGE(S): B-C
APPROVED BY: JAH DATE: 10-4-00
SCALE: 1"= 200 PRIOR INSTRUMENT: VOL 428/536