RASTER

PARENT PARCEL: 14-00-049-000-012 , & 14-00-048-000-002
CHILD PARCEL: 14-00-049-000-013 THRU -015 , 14-00-048-000-004 & -005
STARTING POINT: MON. BOX , CL OF QUARRY RD. & CL OF HUGHS RD.

NO. 00574

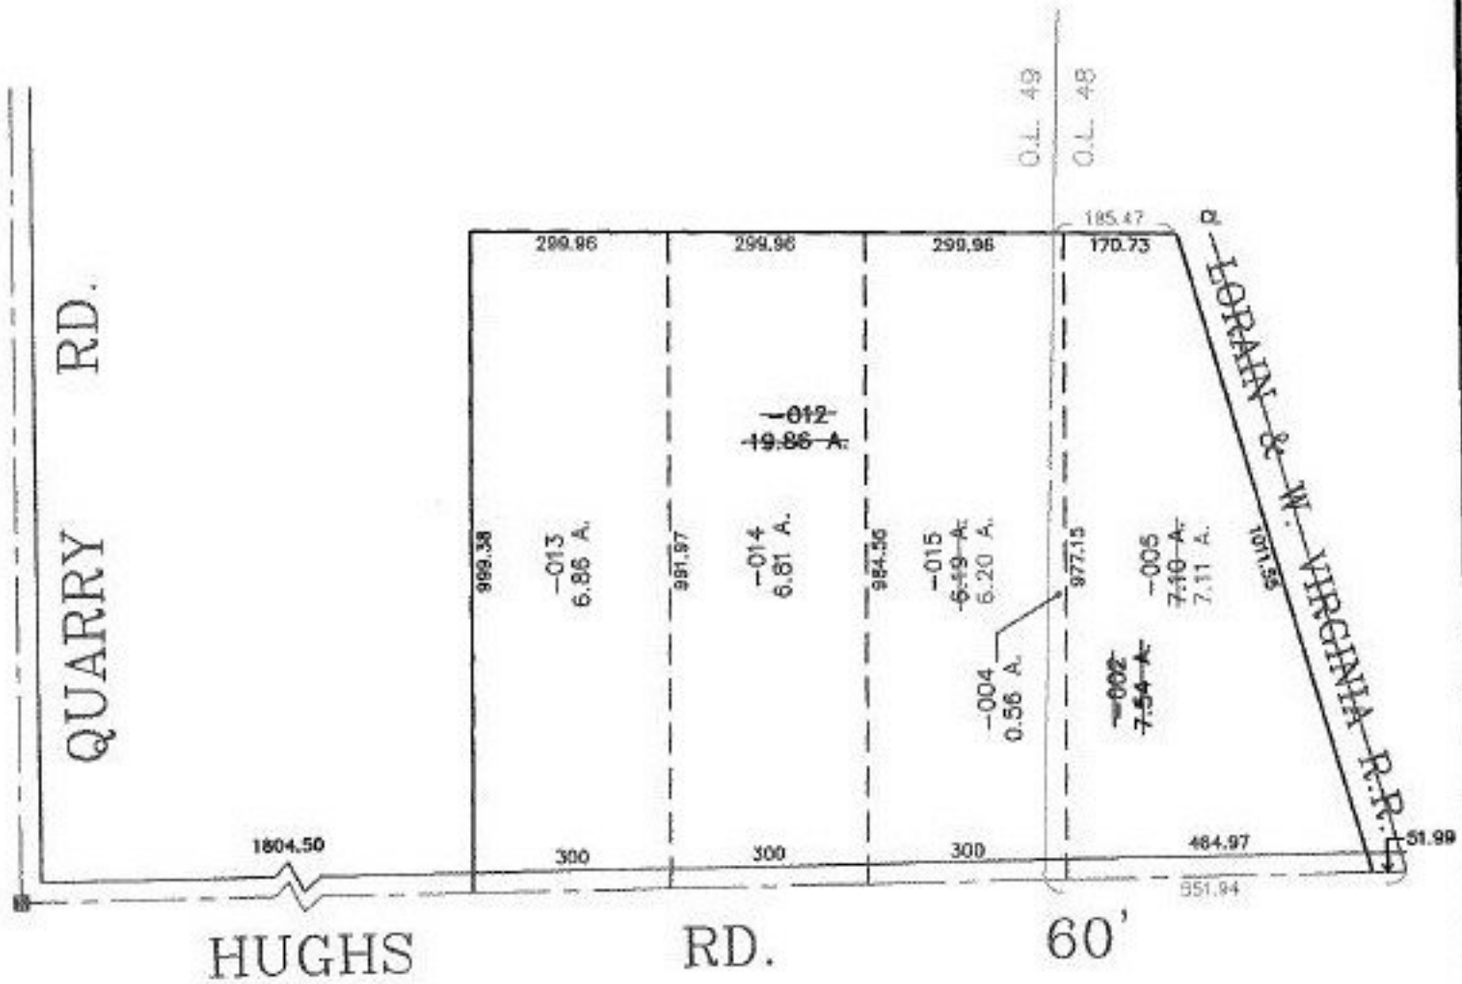

SPLITS/DEEDS PROCESSED
LORAIN COUNTY TAX MAP DEPARTMENT
226 MIDDLE AVE. ELYRIA, OHIO

SURVEYED BY: THOMAS A. SIMON
CLOSURE: 0.03 : 10,000
MAP PAGE(S): 14-A
APPROVED BY: TJS DATE: 10/16/00
SCALE: 1"= 300 PRIOR INSTRUMENT: 20000702990