RASTER

PARENT PARCEL: 01-00-063-000-013
CHILD PARCEL: 01-00-063-000-034 THRU -036
STARTING POINT: CENTERLINE OF GORE ORPHANAGE & MORSE RD.

NO. 00576

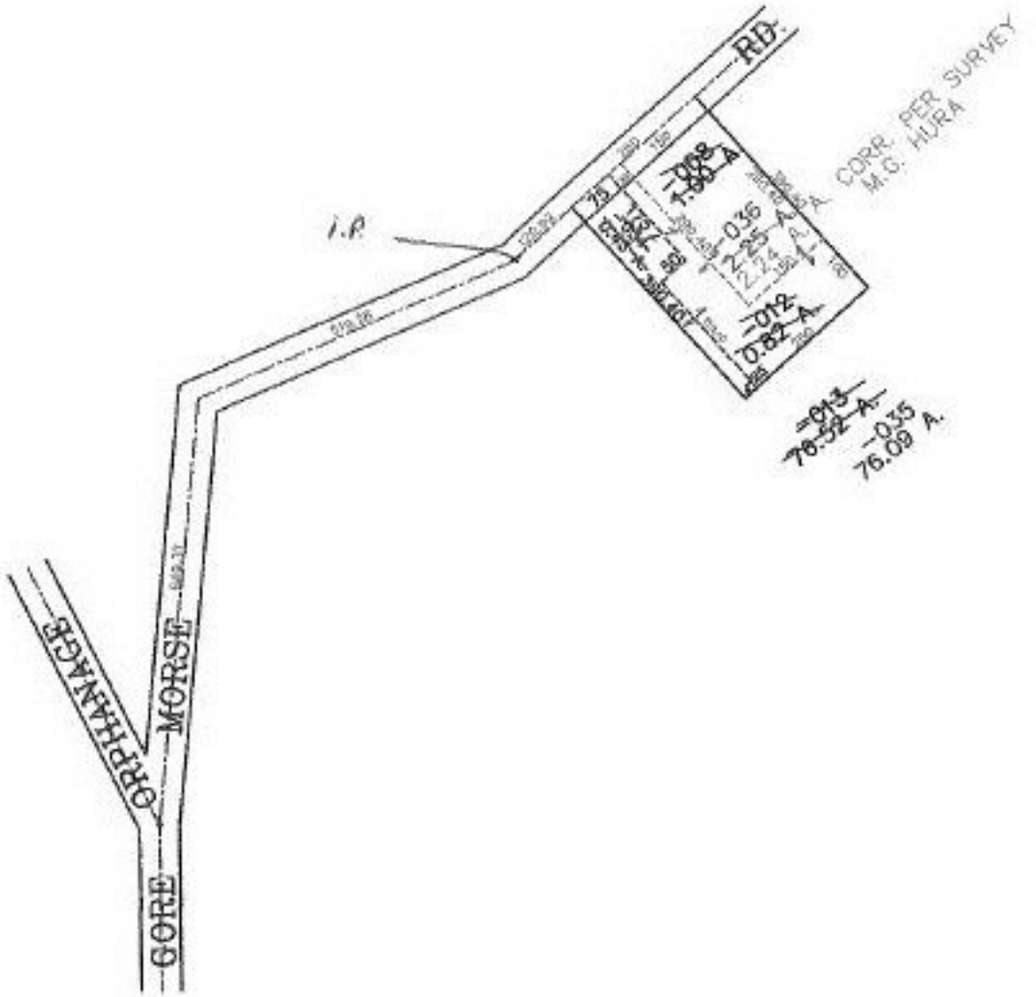

SPLITS/DEEDS PROCESSED
LORAIN COUNTY TAX MAP DEPARTMENT
226 MIDDLE AVE. ELYRIA, OHIO

SURVEYED BY: M.G. HURA
CLOSURE: 0.01 : 10,000
MAP PAGE(S): 1-1
APPROVED BY: JAH DATE: 10-16-00
SCALE: 1" = 300 PRIOR INSTRUMENT: DV 1338/934