PARENT PARCEL: 02-02-010-000-024

CHILD PARCEL: 02-02-010-000-036 THRU -040

STARTING POINT: CL OF KOBE RD. & CL OF JEAGER RD.

NO. 00579

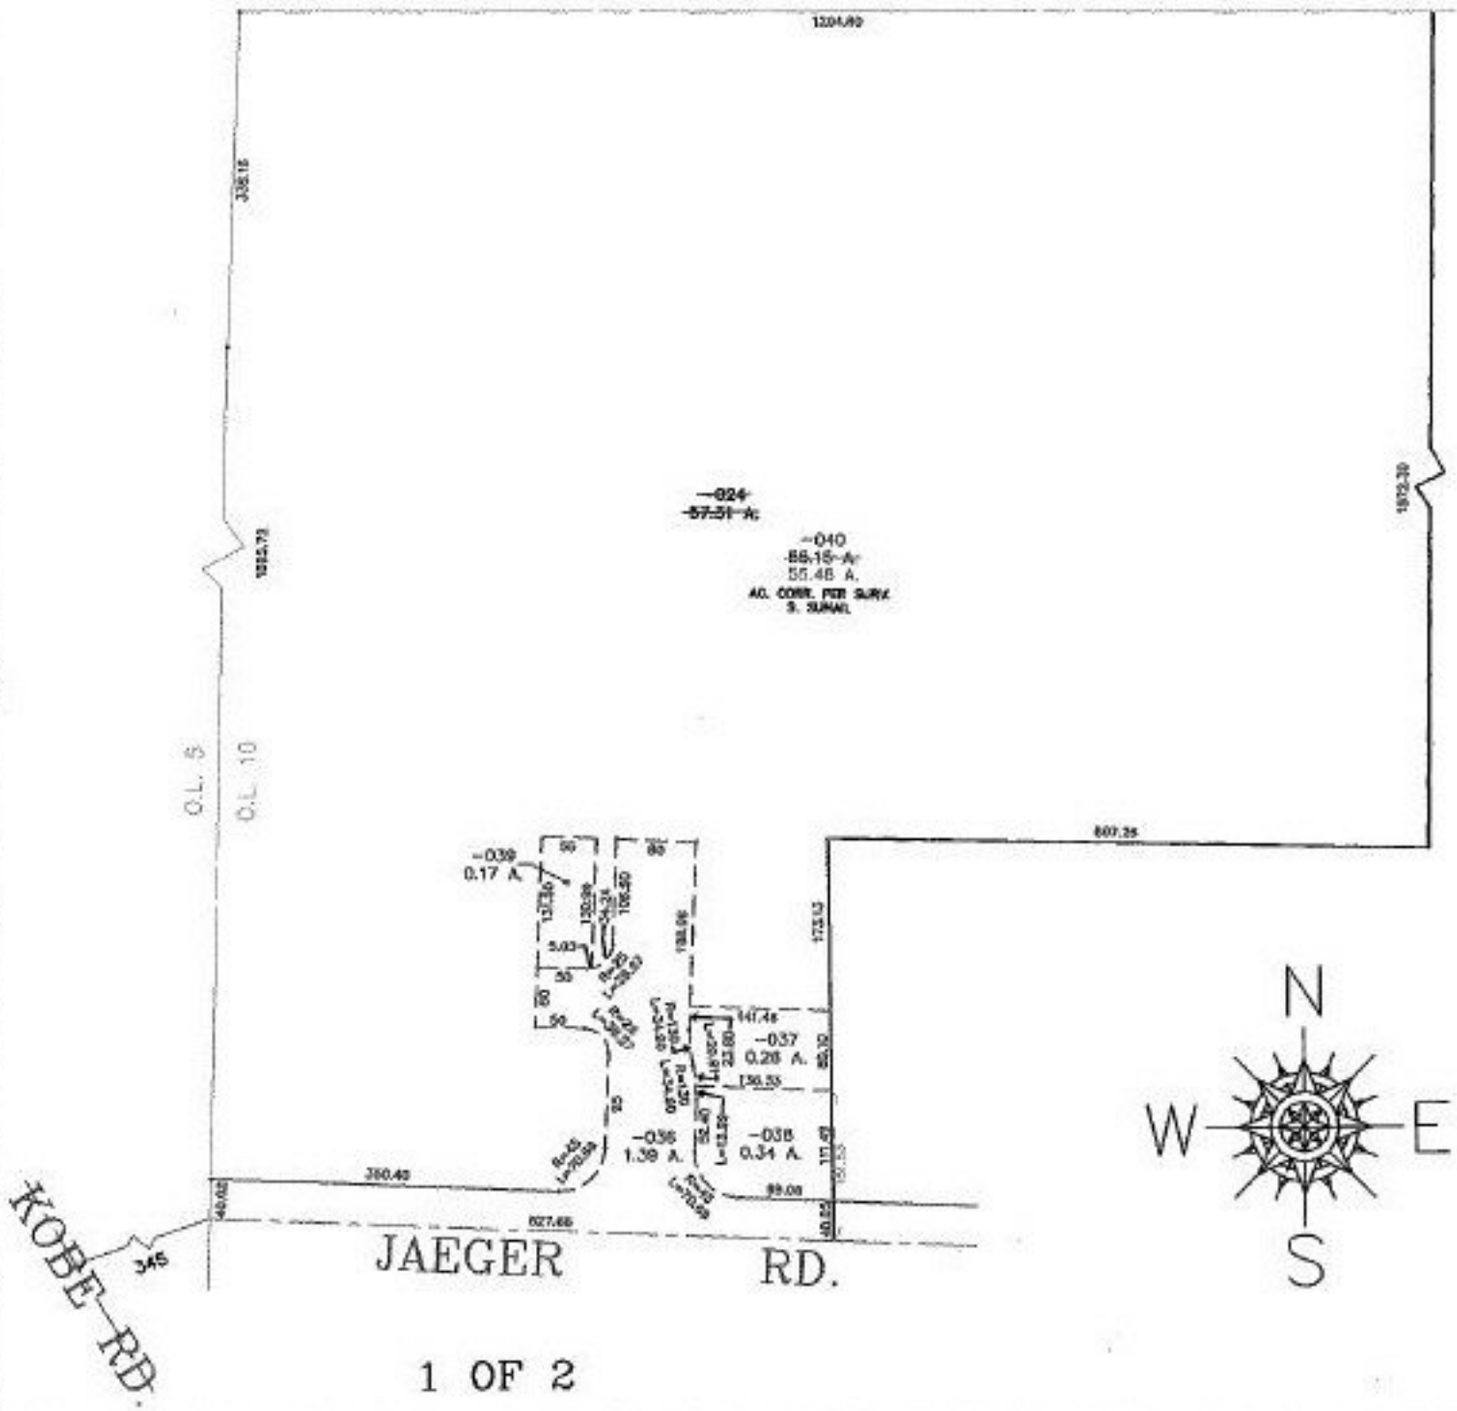

1 OF 2

SPLITS/DEEDS PROCESSED

LORAIN COUNTY TAX MAP DEPARTMENT

226 MIDDLE AVE. ELYRIA, OHIO

SURVEYED BY: SAM SUHAIL

CLOSURE: 0.02 : 10,000

MAP PAGE(S): 02-02-010-A

APPROVED BY: TJS DATE: 10/06/00

SCALE: 1" = 200 PRIOR INSTRUMENT: 20000690166