RASTER

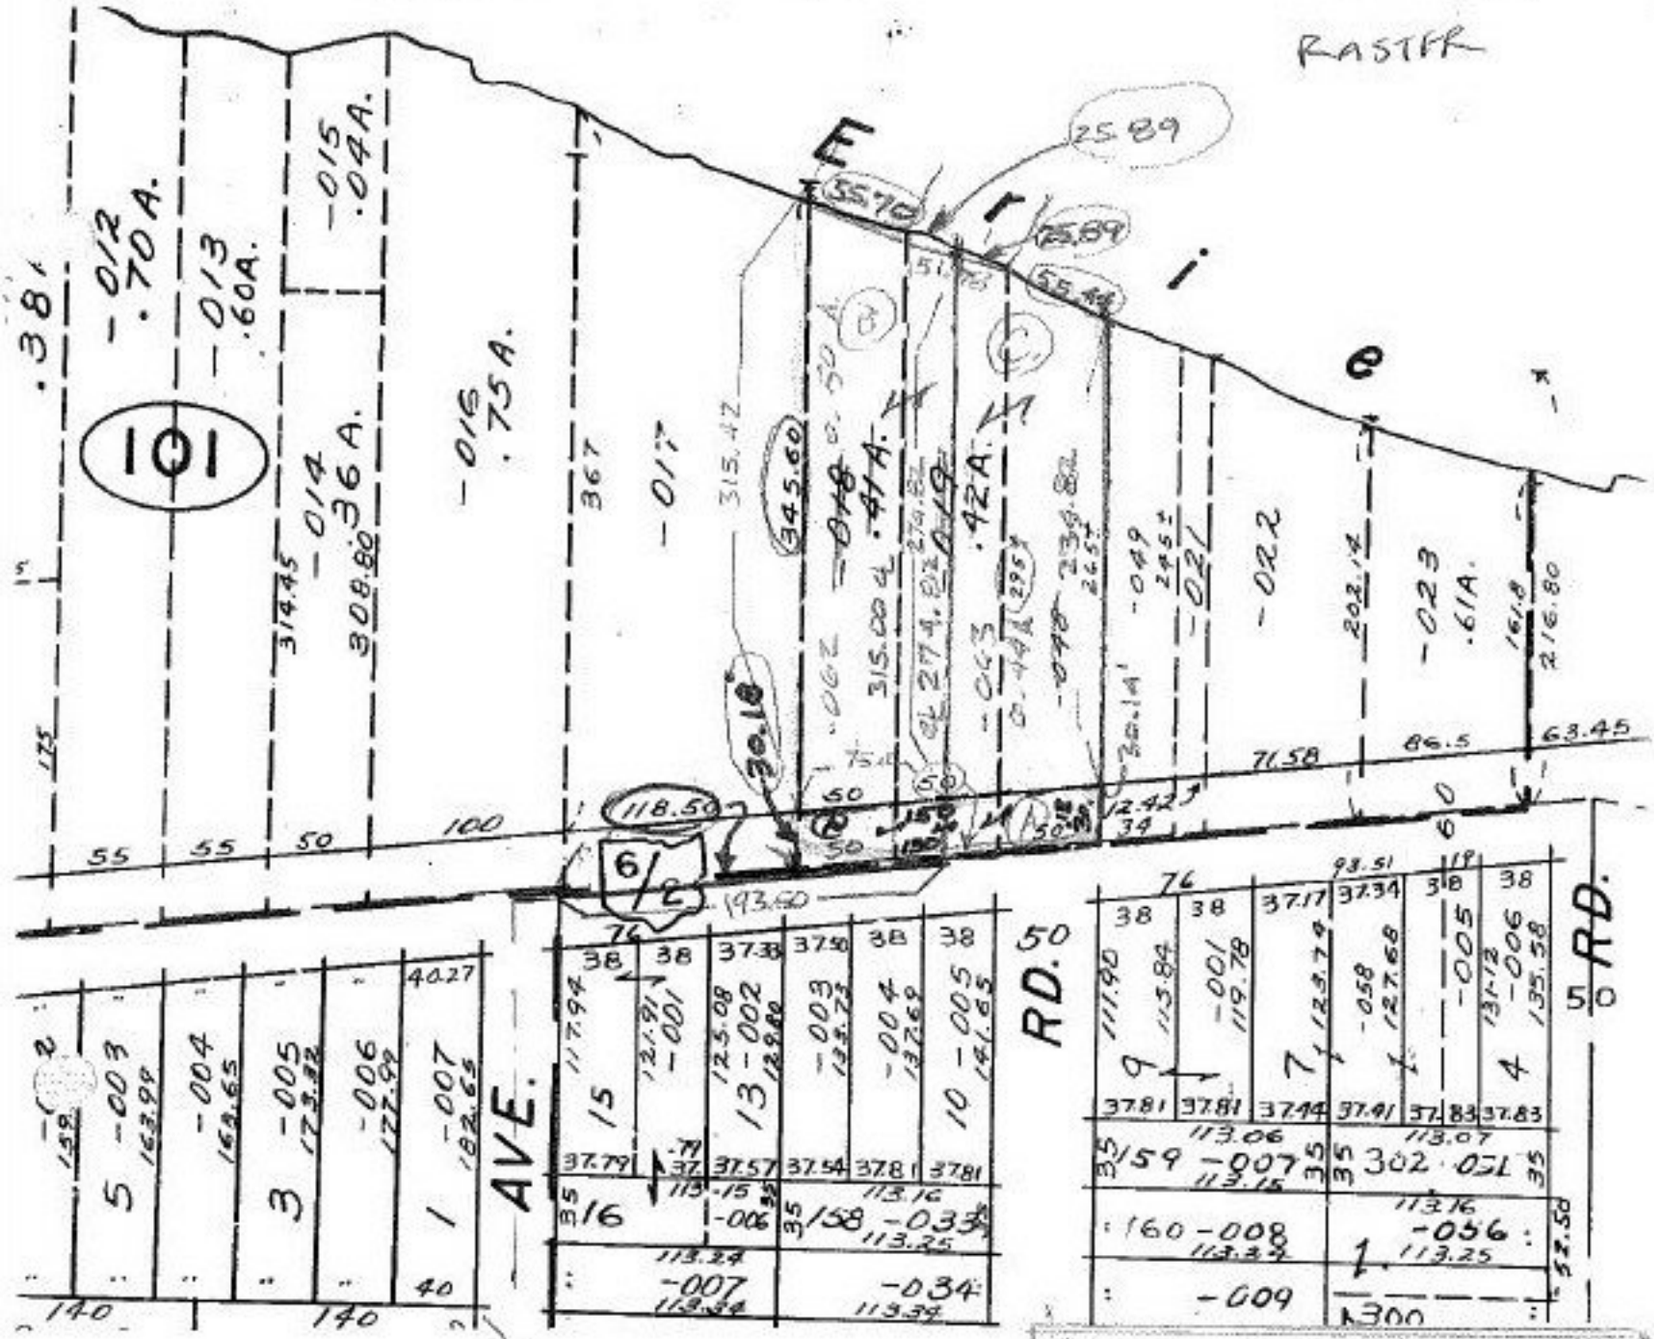

Survey by E. Suhail August '00
Closures (B) 1: INF (C) 1: INF
OR 1484/211
PRIOR INST DEF. OR 111/563

04-00-019-101-

DETAIL N.T.S.

(A) 0.10 A.

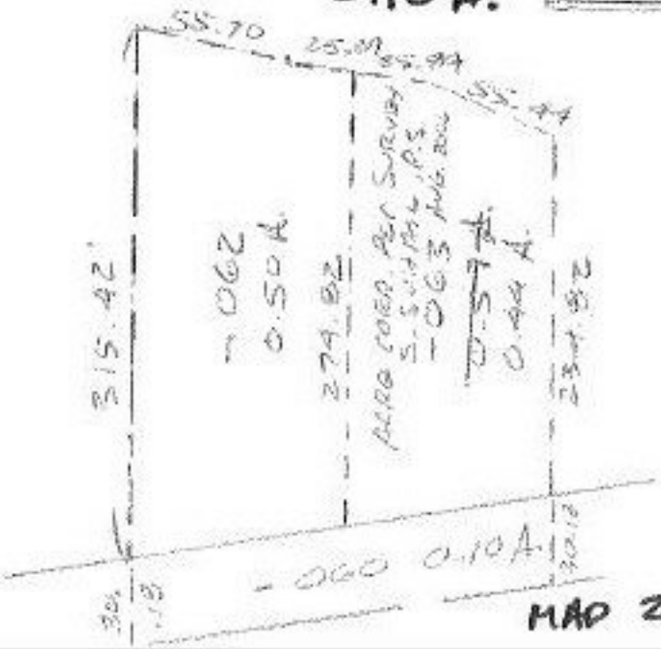

-018 0.41 (B)
-019 0.42
-048 0.34
1.17 (C)
-0.10 (A) -060
1.07
0.50 (B) -062
~~0.57~~
0.44 (C) -063

MAP 2 OF 3

#00 583

APPROVED
LORAIN CO.
MAP DEPT

DATE 10-11-00

PAGE 4.00.019.A

BY T. McNair