RASTER

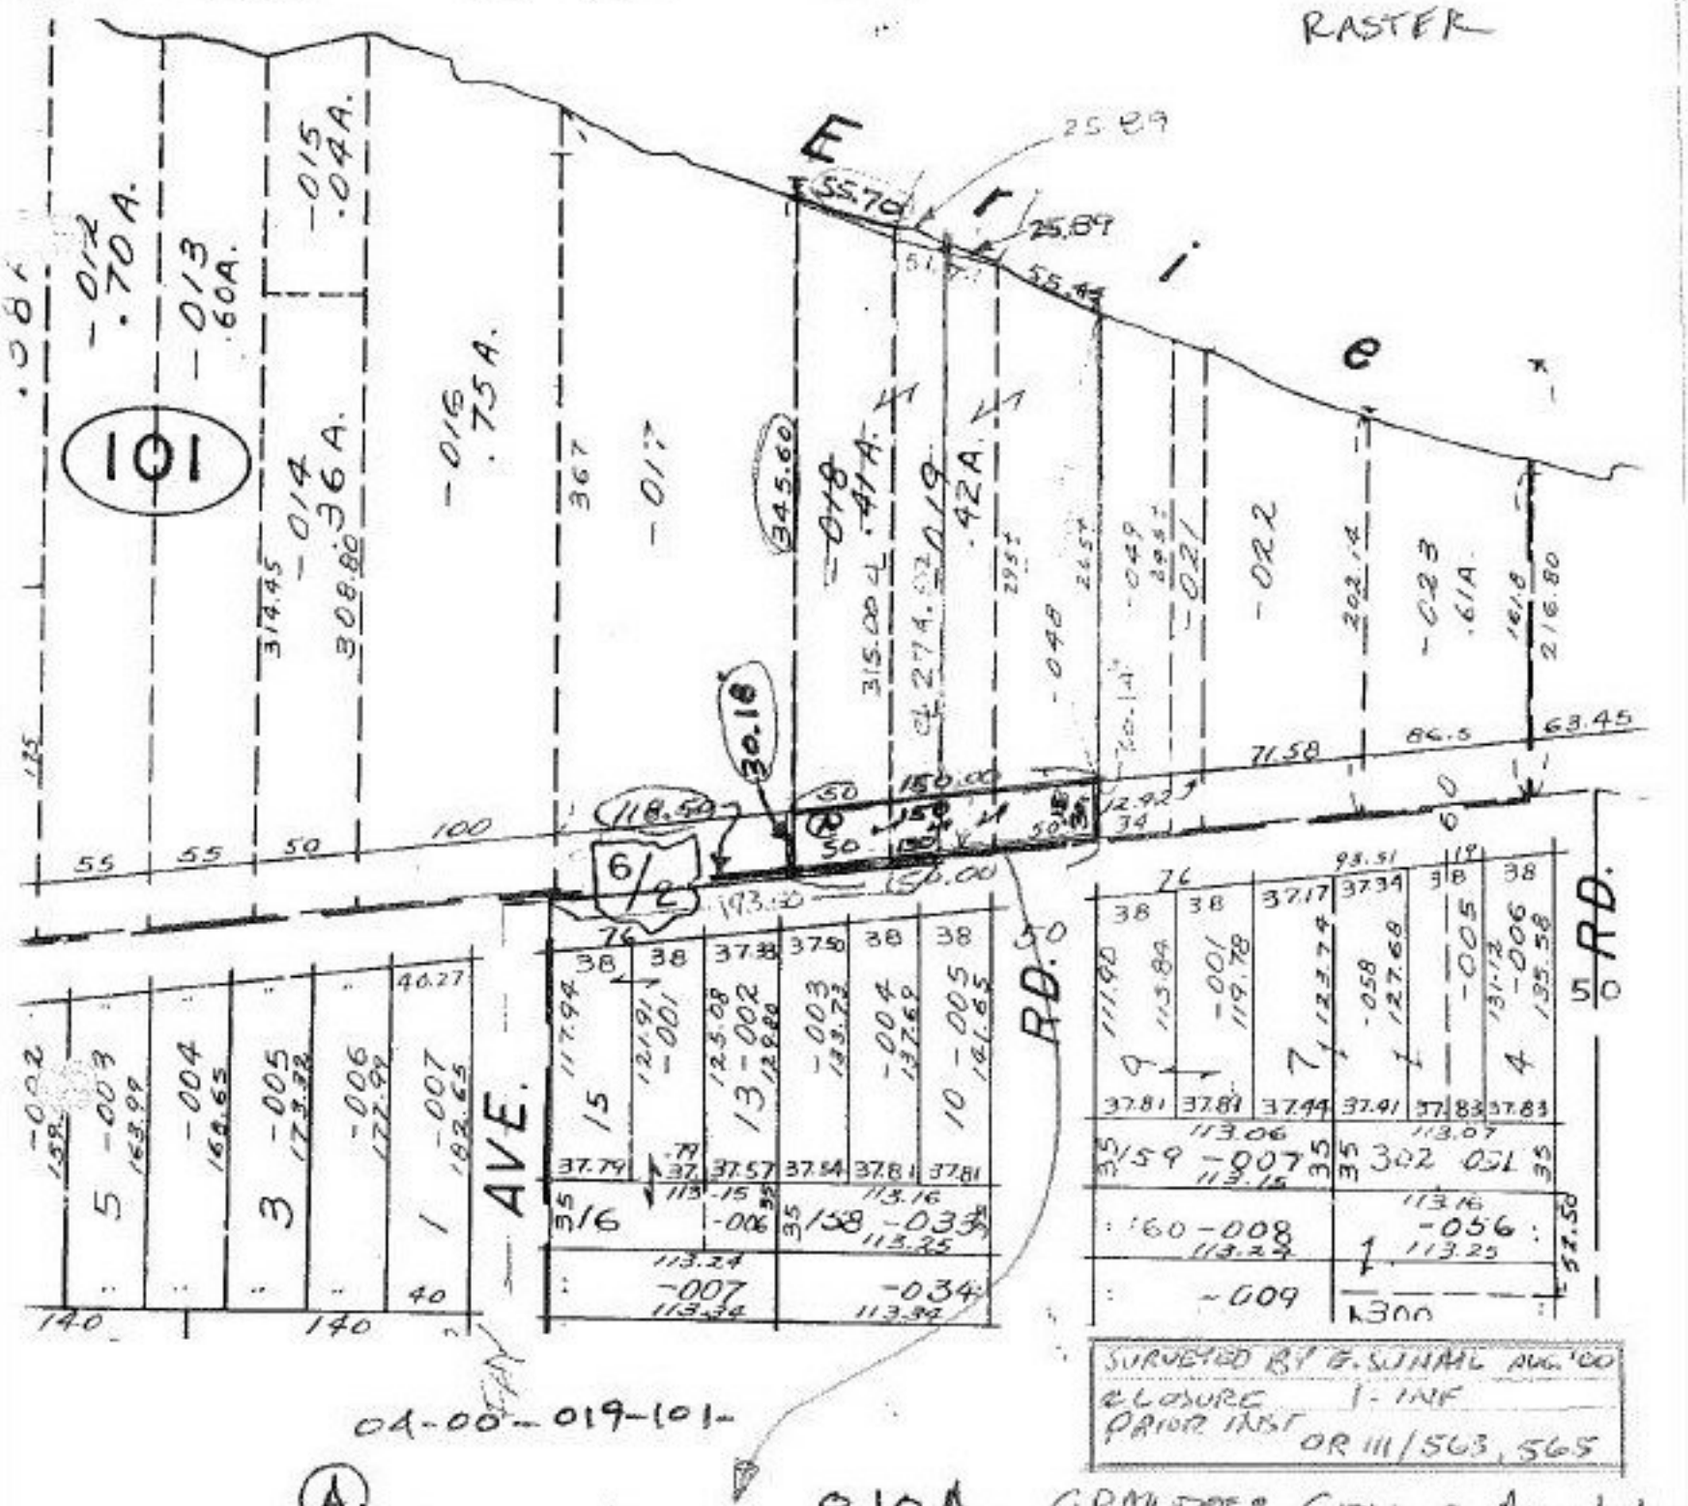

04-00-019-101-

(A) 0.10 A. GRANTEE: CITY OF AVON LAKE

DETAIL N.T.S.

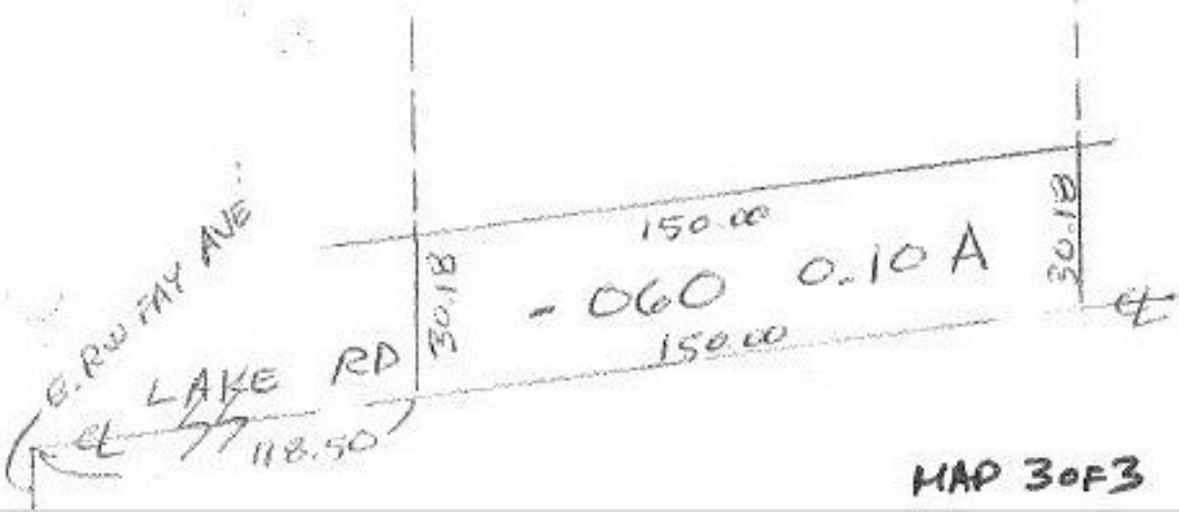

MAP 3 OF 3

#00583

APPROVED
LORAIN CO.
MAP DEPT
DATE 10-11-00
PAGE 100-019-A
BY T. McNair
80583