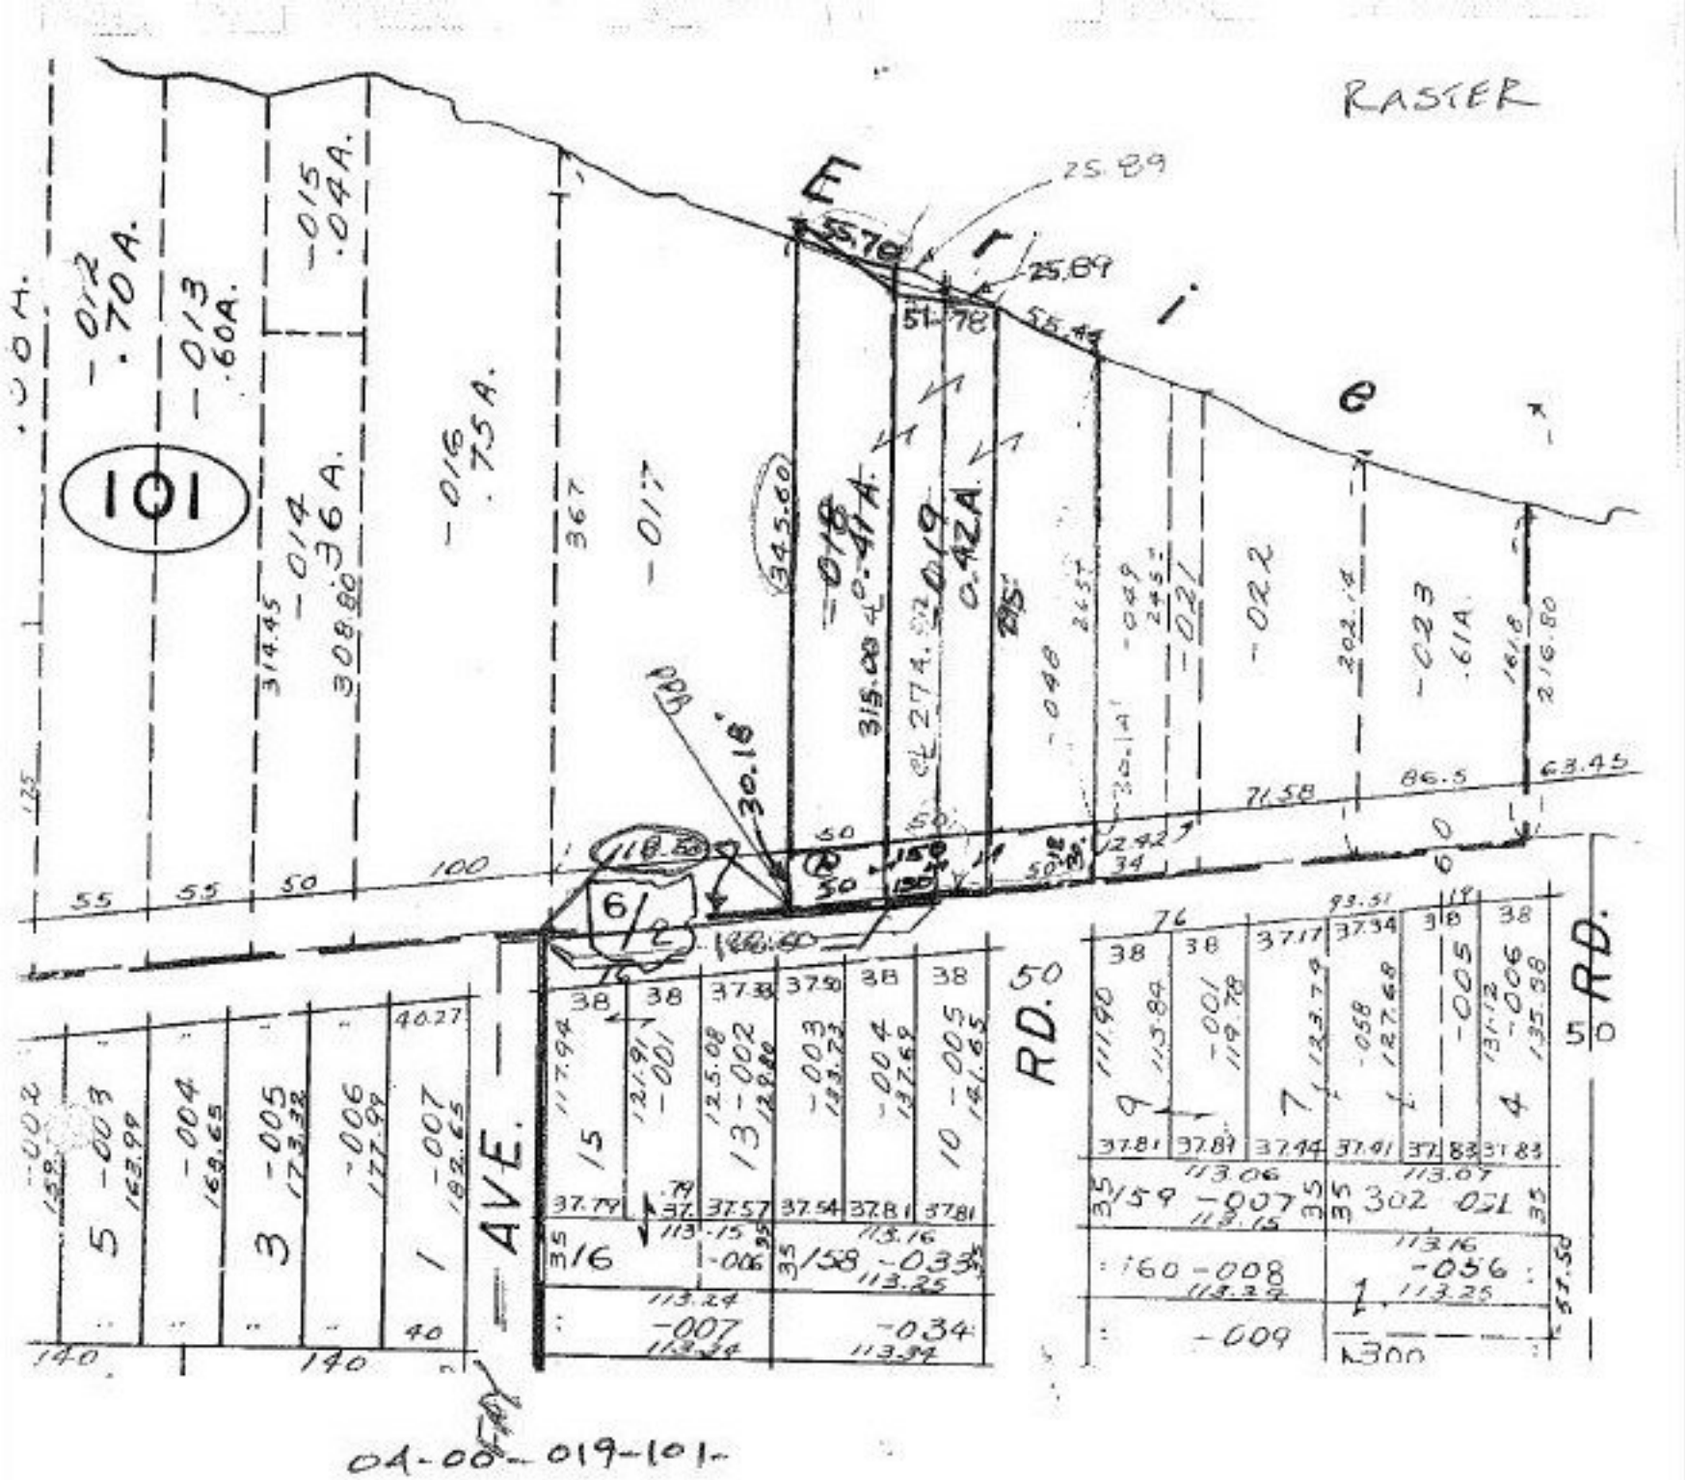

(A) 0.10 A.

#00583

(B) -018 0.41A goes to Centerline Lake Rd

(C) -019 0.42 A goes to Centerline Lake Rd

APPROVED
LORAIN CO.
MAP DEPT
DATE 10-11-00
PAGE 4 00019.A
BY T McKee
00583

MAP 1 OF 3