RASTER

PARENT PARCEL: 05-00-006-000-063
CHILD PARCEL: 05-00-006-000-144 THRU -146
STARTING POINT: CENTERLINE OF MIDDLE RIDGE RD. & S. LAKE ST.

NO. 00585

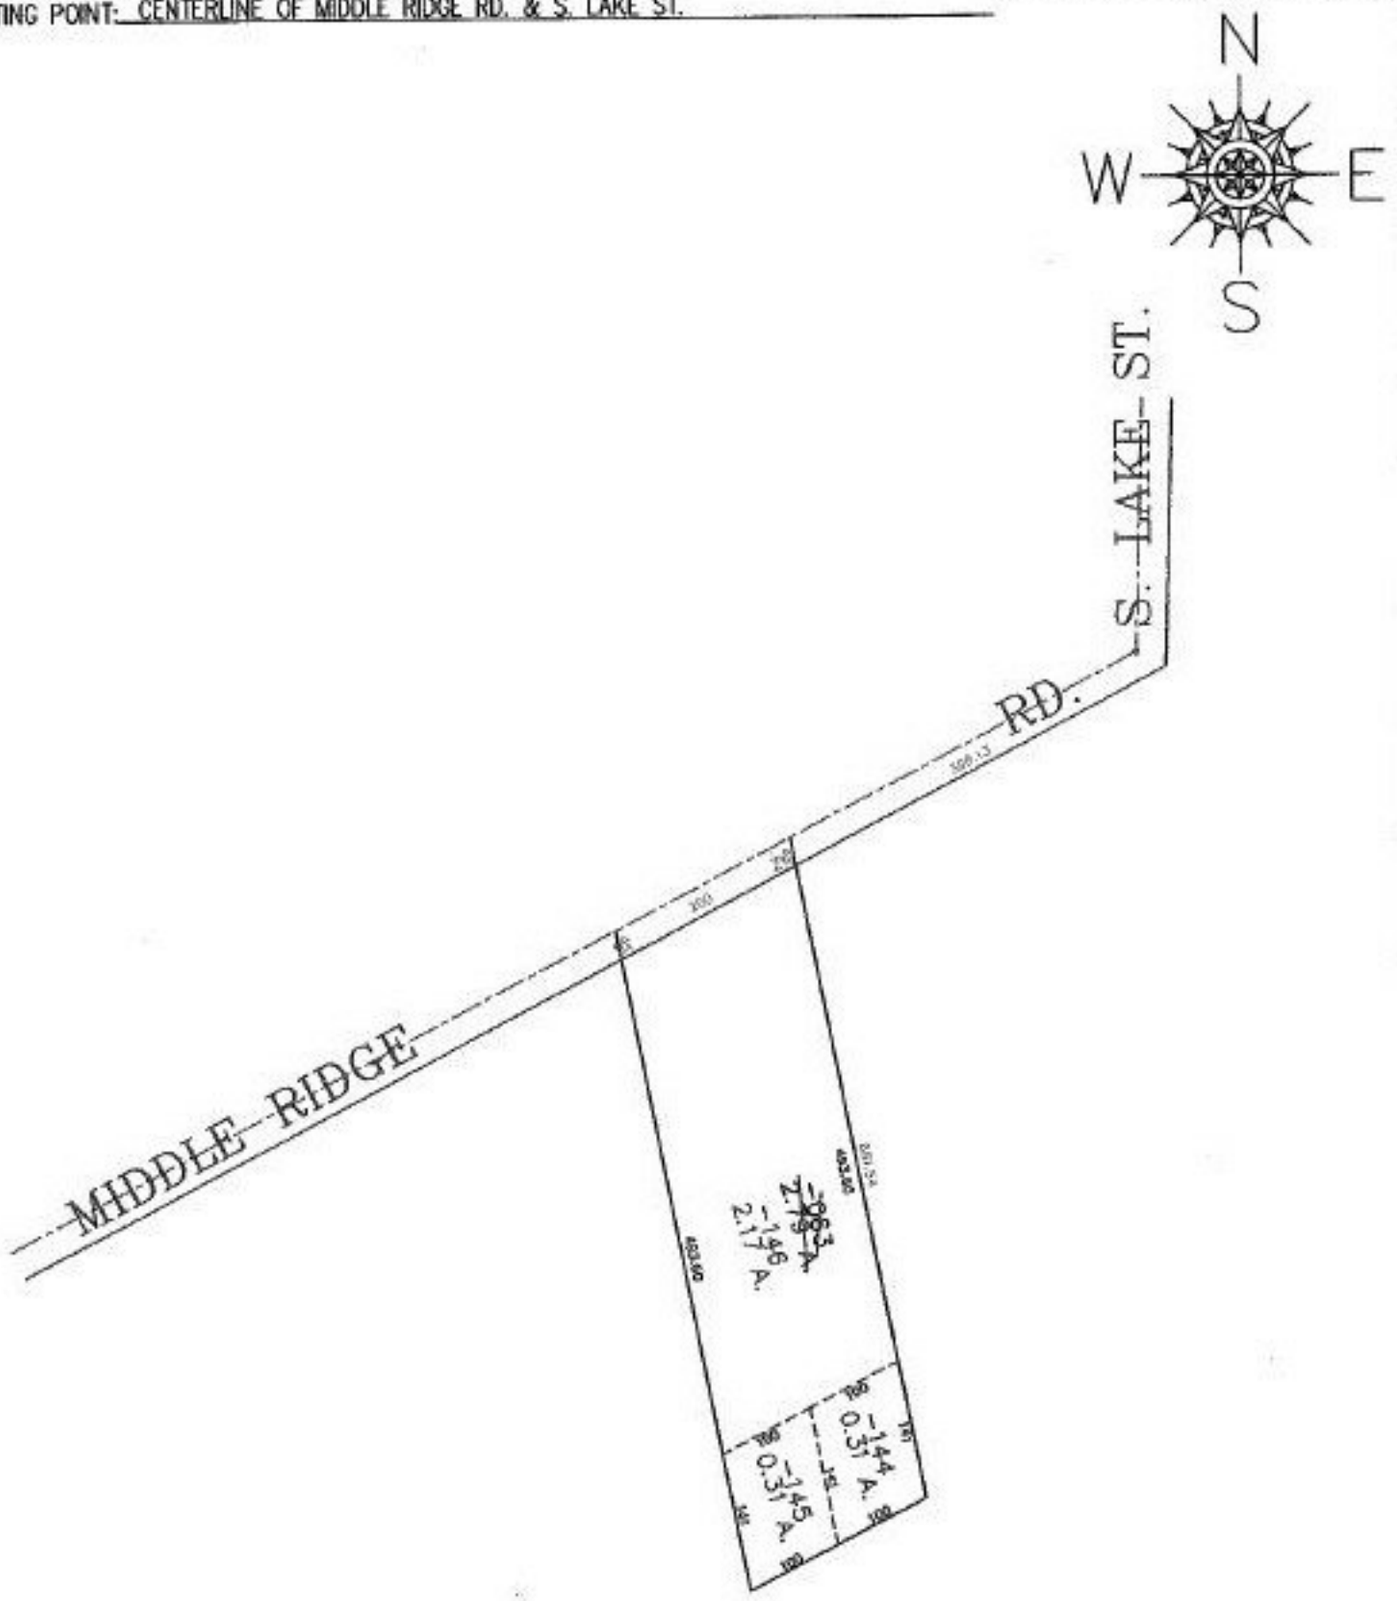

SPLITS/DEEDS PROCESSED
LORAIN COUNTY TAX MAP DEPARTMENT
226 MIDDLE AVE. ELYRIA, OHIO

SURVEYED BY: JOHN POZYWAK
CLOSURE: 0.00 : 10,000
MAP PAGE(S): 5-00-006-A
APPROVED BY: JAH DATE: 10/17/00
SCALE: 1"= 200 PRIOR INSTRUMENT: OR 534/348