RASTER

PARENT PARCEL: 17-07-010-000-002, -003, -004, -009, -010

CHILD PARCEL: 17-07-010-000-014, -015, -016

STARTING POINT: CENTERLINES OF MEDINA NORWALK RD. & QUARRY RD.

NO. 00587

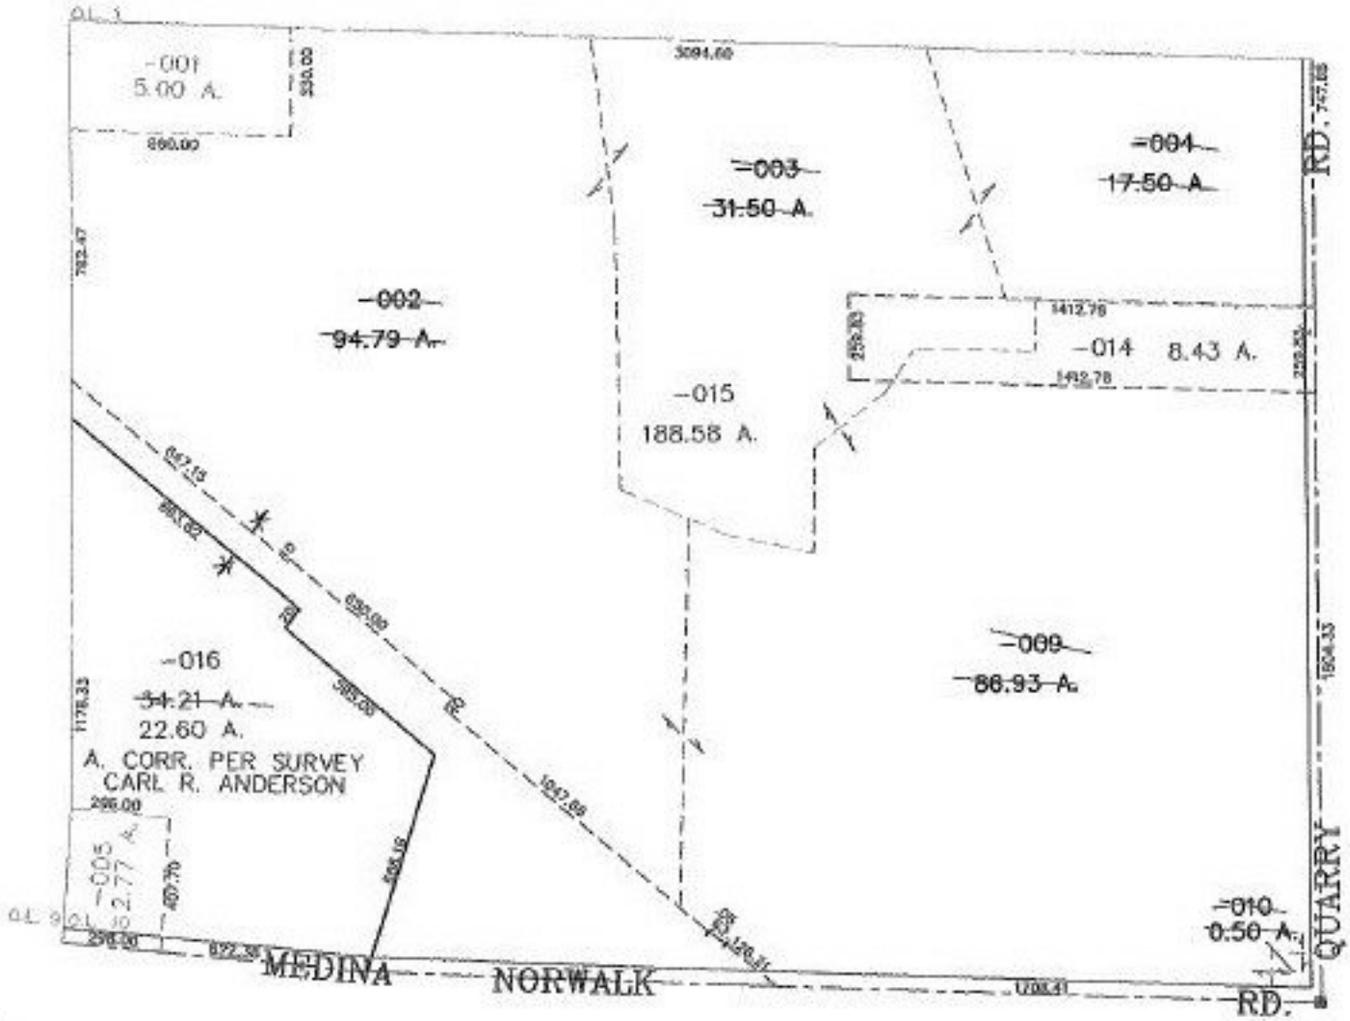

SPLITS/DEEDS PROCESSED

LORAIN COUNTY TAX MAP DEPARTMENT
226 MIDDLE AVE. ELYRIA, OHIO

SURVEYED BY: CARL R. ANDERSON

CLOSURE: 0.01 : 10,000

MAP PAGE(S): 17-0

APPROVED BY: JAH DATE: 01-22-01

SCALE: 1" = 600 PRIOR INSTRUMENT: DV 1082/778