RASTER

PARENT PARCEL: 03-00-007-102-030 & -031

CHILD PARCEL: 03-00-007-102-051 THRU -054

STARTING POINT: CL OF COLORADO AVE. & EAST LINE OF O.L. 7

NO. 00592

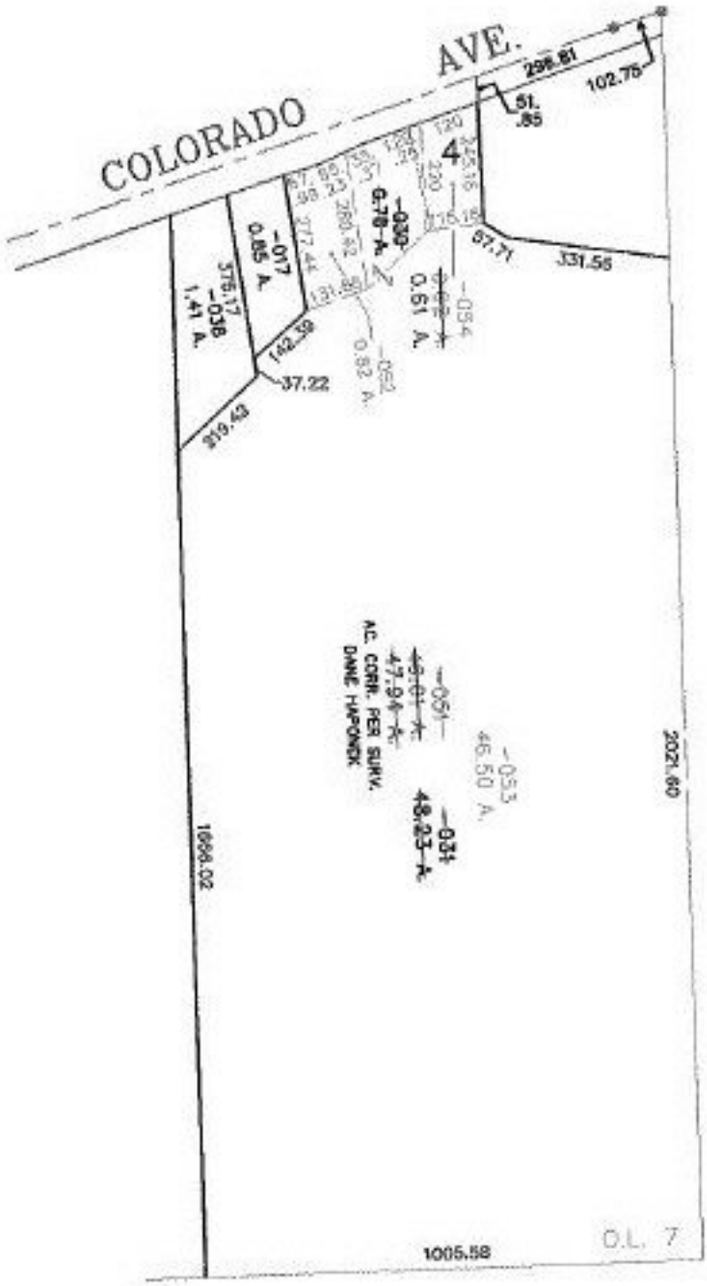

SPLITS/DEEDS PROCESSED

LORAIN COUNTY TAX MAP DEPARTMENT

226 MIDDLE AVE. ELYRIA, OHIO

SURVEYED BY: DANE A. HAPONEK

CLOSURE: 0.10 : 10,000

MAP PAGE(S): 3-00-007-B

APPROVED BY: TJS DATE: 10/31/00

SCALE: 1" = 400 PRIOR INSTRUMENT: DV 1257/565