RASTER

PARENT PARCEL: 11-00-047-000-025
CHILD PARCEL: 11-00-047-000-045, -046
STARTING POINT: CENTERLINE OF COOLEY RD. & O.L. 47

NO. 00594

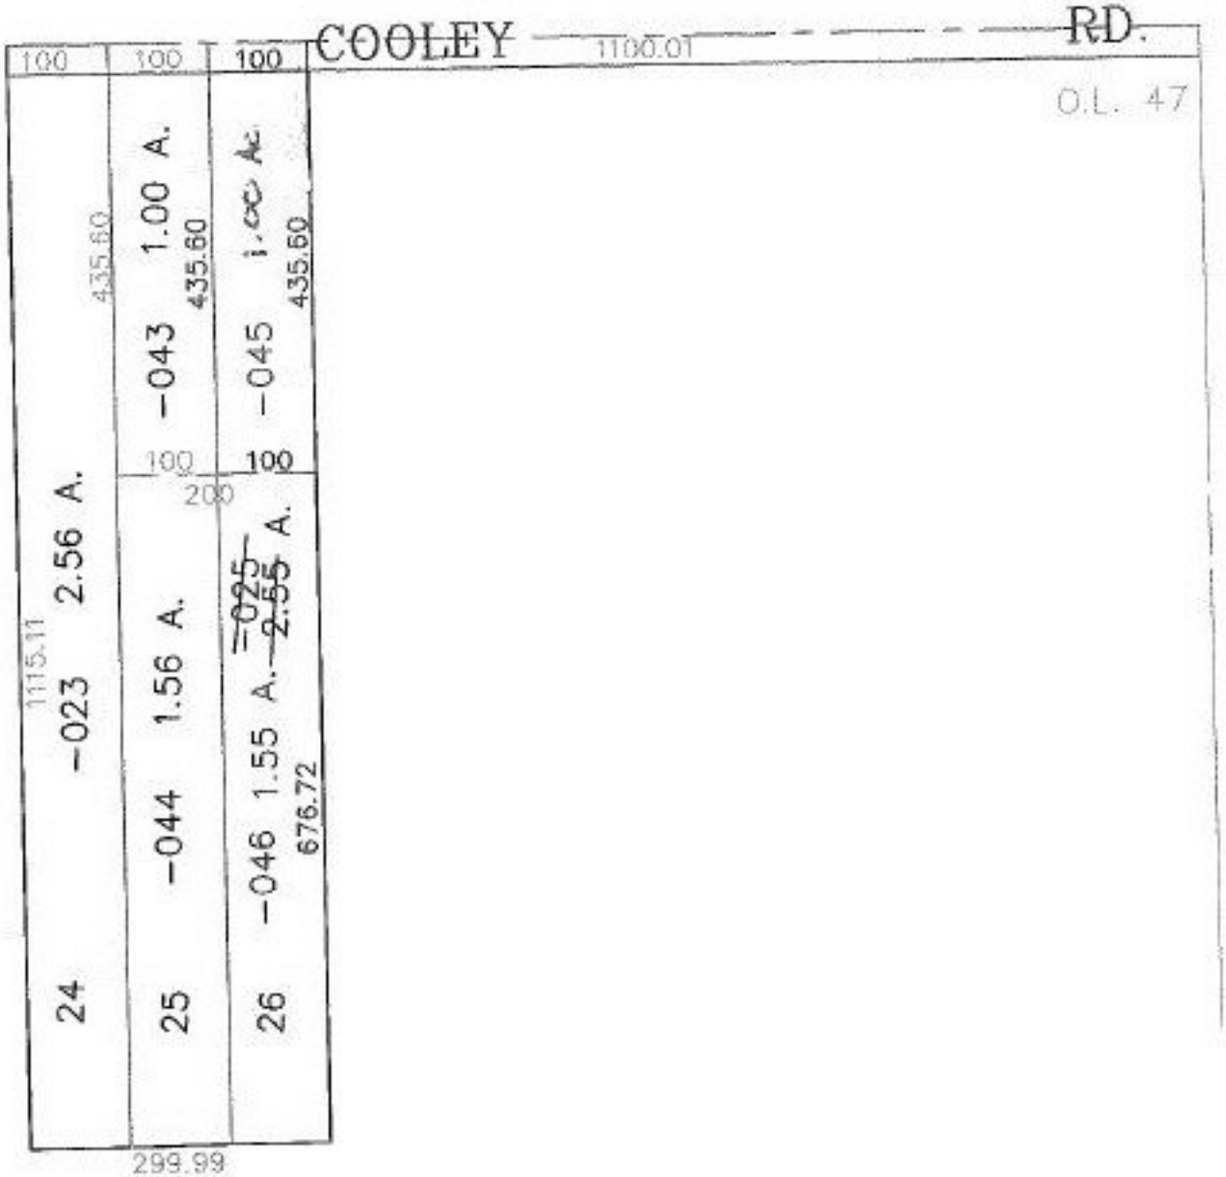

SPLITS/DEEDS PROCESSED
LORAIN COUNTY TAX MAP DEPARTMENT
226 MIDDLE AVE. ELYRIA, OHIO

SURVEYED BY: THOMAS A. SIMON
CLOSURE: 0.01 : 10,000
MAP PAGE(S): 11-00-047-B
APPROVED BY: JAH DATE: 12-7-00
SCALE: 1"= 200 PRIOR INSTRUMENT: 980583572