FASTFR

PARENT PARCEL: 12-00-058-000-040
CHILD PARCEL: 12-00-058-000-041, -042, -043
STARTING POINT: CENTERLINE OF NICHOLS RD. & O.L. 58

NO. 00603

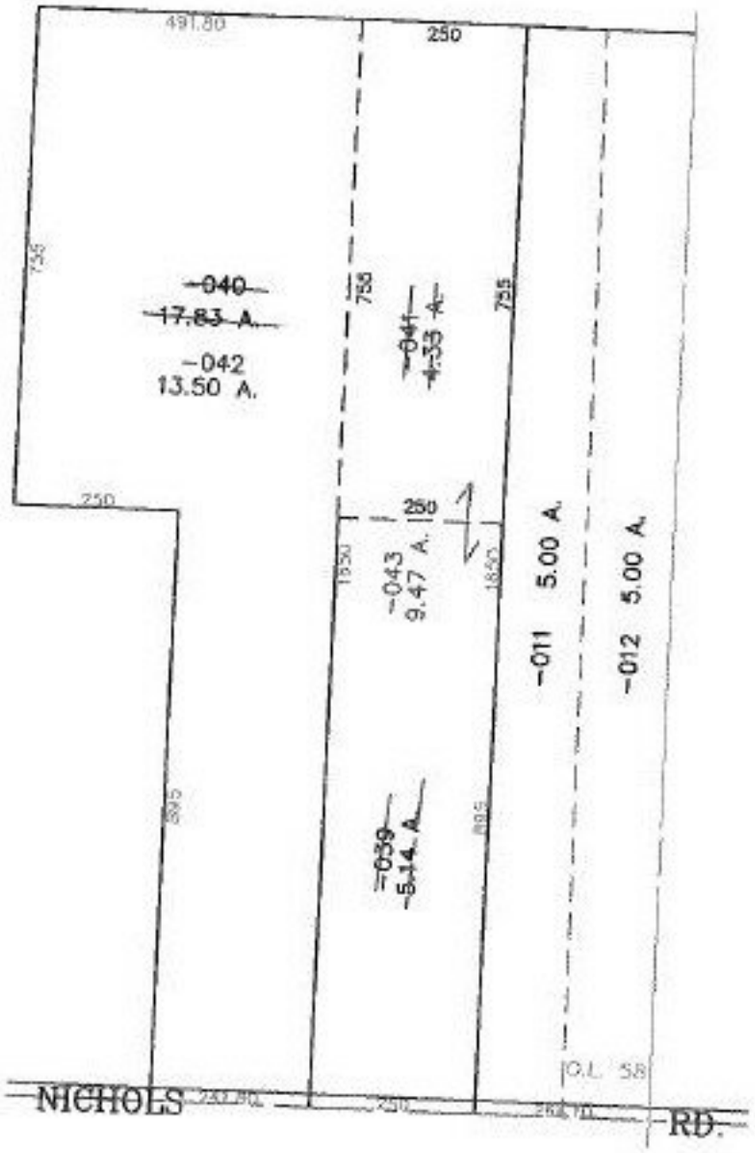

SPLITS/DEEDS PROCESSED
LORAIN COUNTY TAX MAP DEPARTMENT
226 MIDDLE AVE. ELYRIA, OHIO

SURVEYED BY: GEORGE A. HOFMANN
CLOSURE: 0.02 :10,000
MAP PAGE(S): 12-B
APPROVED BY: JAH DATE: 11/19/00
SCALE: 1"= 300 PRIOR INSTRUMENT: OR 1409/142