RASTER

PARENT PARCEL: 05-00-006-000-061
CHILD PARCEL: 05-00-006-000-147 THRU -149
STARTING POINT: CENTERLINE OF MIDDLE RIDGE RD. & O.L. 6

NO. 00607

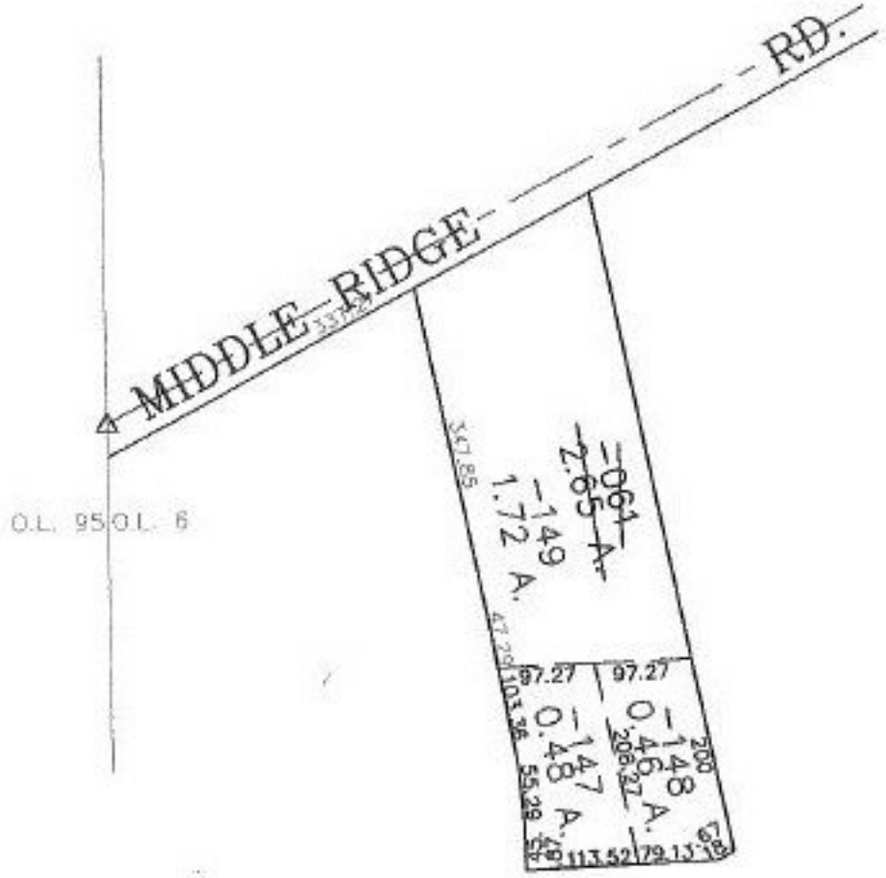

SPLITS/DEEDS PROCESSED
LORAIN COUNTY TAX MAP DEPARTMENT
226 MIDDLE AVE. ELYRIA, OHIO

SURVEYED BY: PHILLIP A. ROSEBECK
CLOSURE: 0.03 : 10,000
MAP PAGE(S): 05-00-006-A
APPROVED BY: JAH DATE: 11/28/00
SCALE: 1" = 200 PRIOR INSTRUMENT: 19980539592