RASTER

PARENT PARCEL: 16-00-057-000-007
CHILD PARCEL: 16-00-057-000-014 THRU -017
STARTING POINT: CENTERLINE OF MENNEL RD. & O.L. 57

NO. 00611

N
W E
S

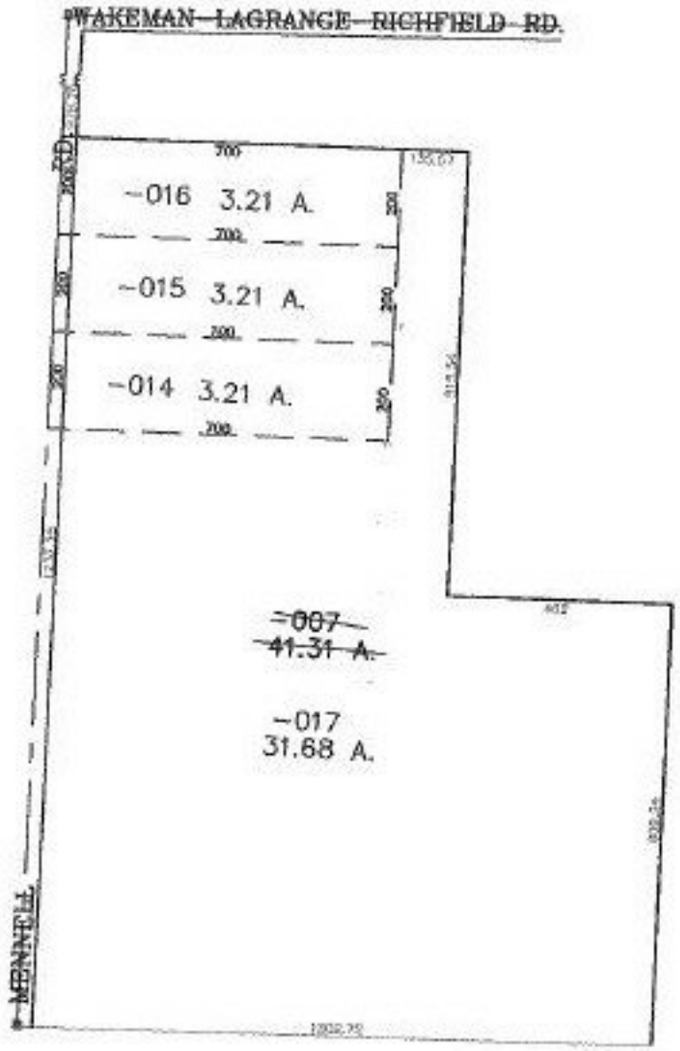

SPLITS/DEEDS PROCESSED
LORAIN COUNTY TAX MAP DEPARTMENT
226 MIDDLE AVE. ELYRIA, OHIO

SURVEYED BY: RODGER G. SIMON
CLOSURE: 0.00 : 10,000
MAP PAGE(S): 4-00-015-B
APPROVED BY: JAH DATE: 11-30-00
SCALE: 1" = 200 PRIOR INSTRUMENT: OR 273 P. 715