RASTER

PARENT PARCEL: 03-00-005-000-056, -215
CHILD PARCEL: 03-00-005-000-057 thru -060
STARTING POINT: RAILROAD SPIKE IN THE CENTERLINE OF ABBE RD. & EVERGRREN PARKWAY

NO. 00623

N
W E
S

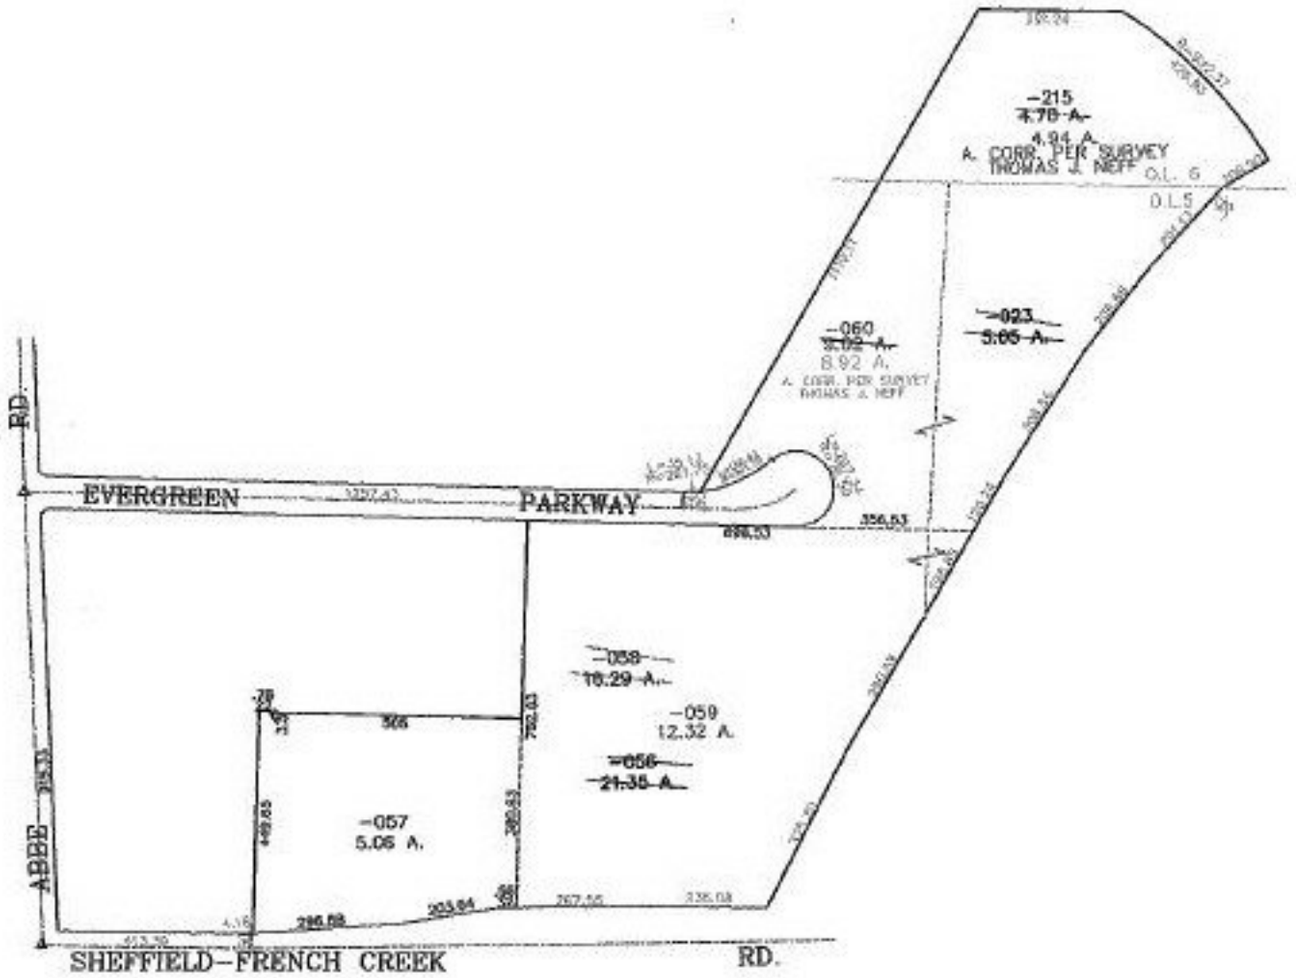

SPLITS/DEEDS PROCESSED

LORAIN COUNTY TAX MAP DEPARTMENT
226 MIDDLE AVE. ELYRIA, OHIO

SURVEYED BY: THOMAS J. NEFF
CLOSURE: 0.12 : 10,000
MAP PAGE(S): 3-00-005-A, B -006-B
APPROVED BY: JAH DATE: 12-14-00
SCALE: 1"= 400 PRIOR INSTRUMENT: OR 166/273