RASTER

PARENT PARCEL: 12-00-020-123-003
CHILD PARCEL: 12-00-020-123-019, -020
STARTING POINT: CENTERLINE OF REDFERN RD. & O.L. 20

NO. 00628

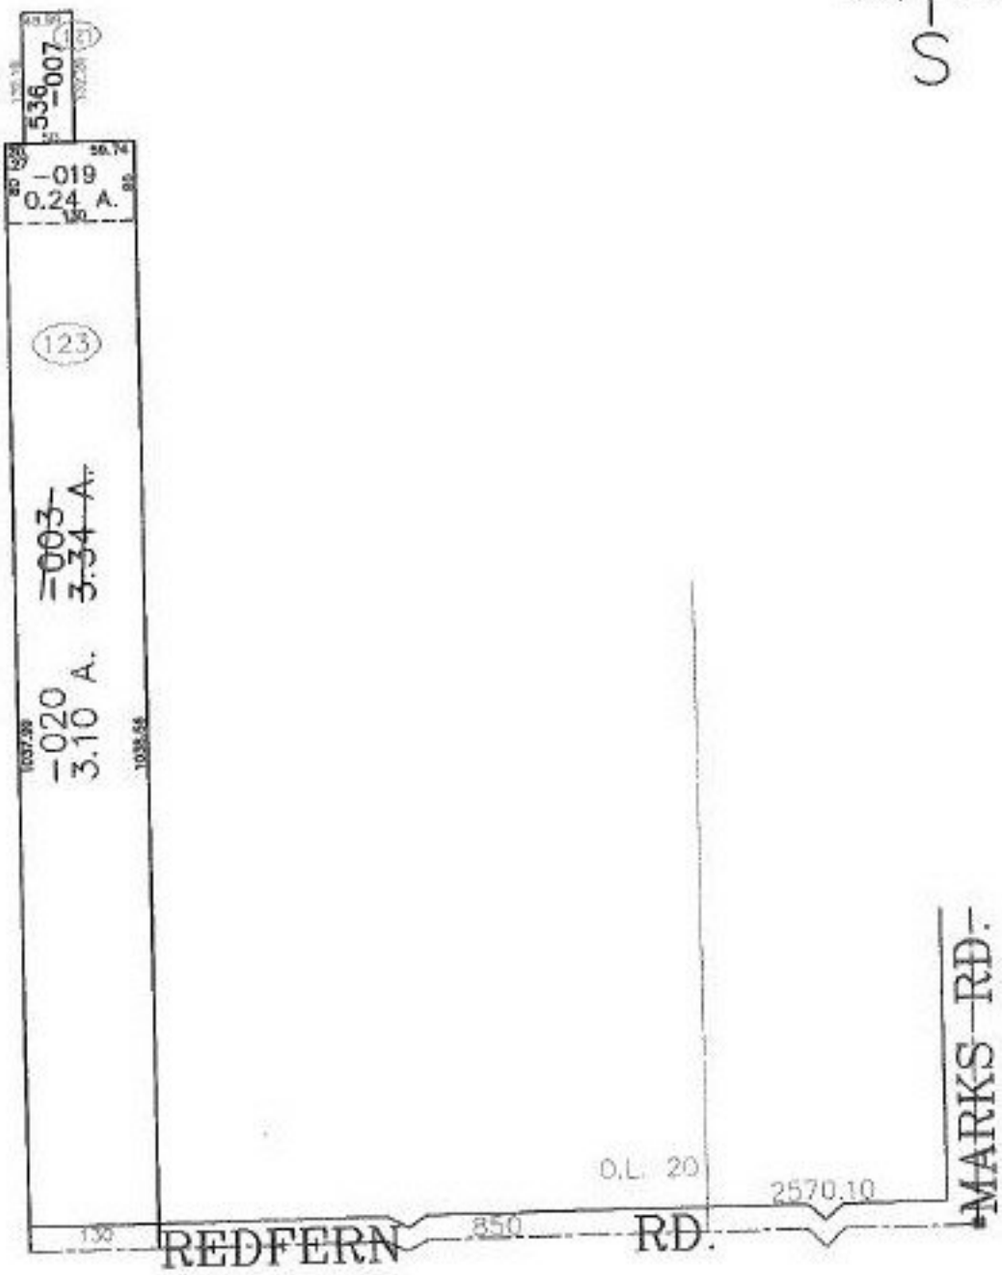

SPLITS/DEEDS PROCESSED
LORAIN COUNTY TAX MAP DEPARTMENT
226 MIDDLE AVE. ELYRIA, OHIO

SURVEYED BY: GEORGE A. HOFFMAN
CLOSURE: 0.02 : 10,000
MAP PAGE(S): 12-00-020-B
APPROVED BY: JAH DATE: 12-27-00
SCALE: 1"= 200 PRIOR INSTRUMENT: 200598824