RASTER

PARENT PARCEL: 15-00-054-000-020
CHILD PARCEL: 15-00-054-000-021 THRU -028
STARTING POINT: CENTERLINE OF WAKEMAN-LAGRANGE-RICHFIELD RD. & WHEELER RD.

NO. 00629

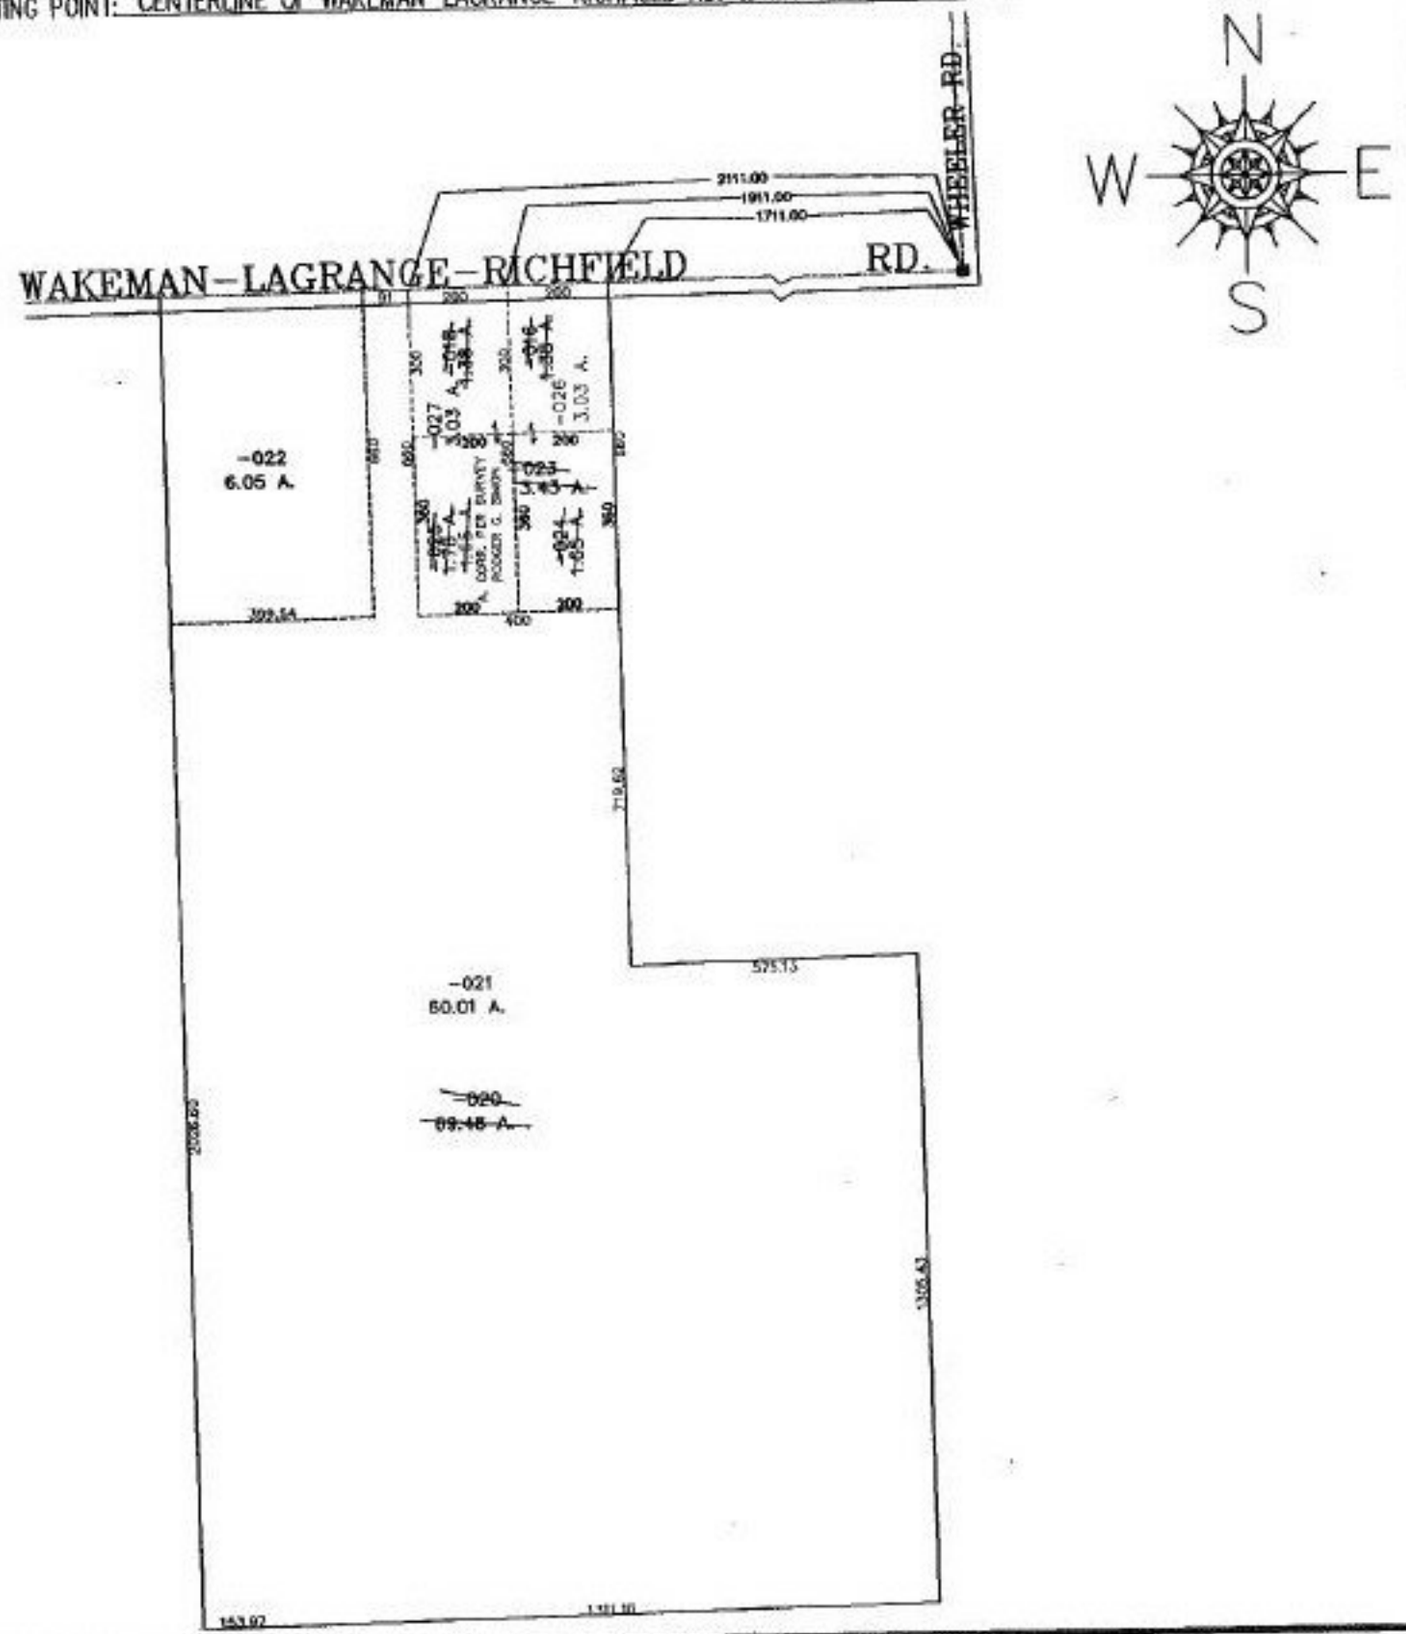

SPLITS/DEEDS PROCESSED
LORAIN COUNTY TAX MAP DEPARTMENT
226 MIDDLE AVE. ELYRIA, OHIO

SURVEYED BY: RODGER G. SIMON
CLOSURE: 0.00 : 10.000
MAP PAGE(S): 15-G
APPROVED BY: JAH DATE: 12-27-00
SCALE: 1"= 400 PRIOR INSTRUMENT: OR 316/943