RASTER

PARENT PARCEL: 03-00-108-103-013
CHILD PARCEL: 03-00-108-103-020 & -021
STARTING POINT: MON. BOX , CL OF 43RD ST. & CL OF BROADWAY AVE.

NO. 00630

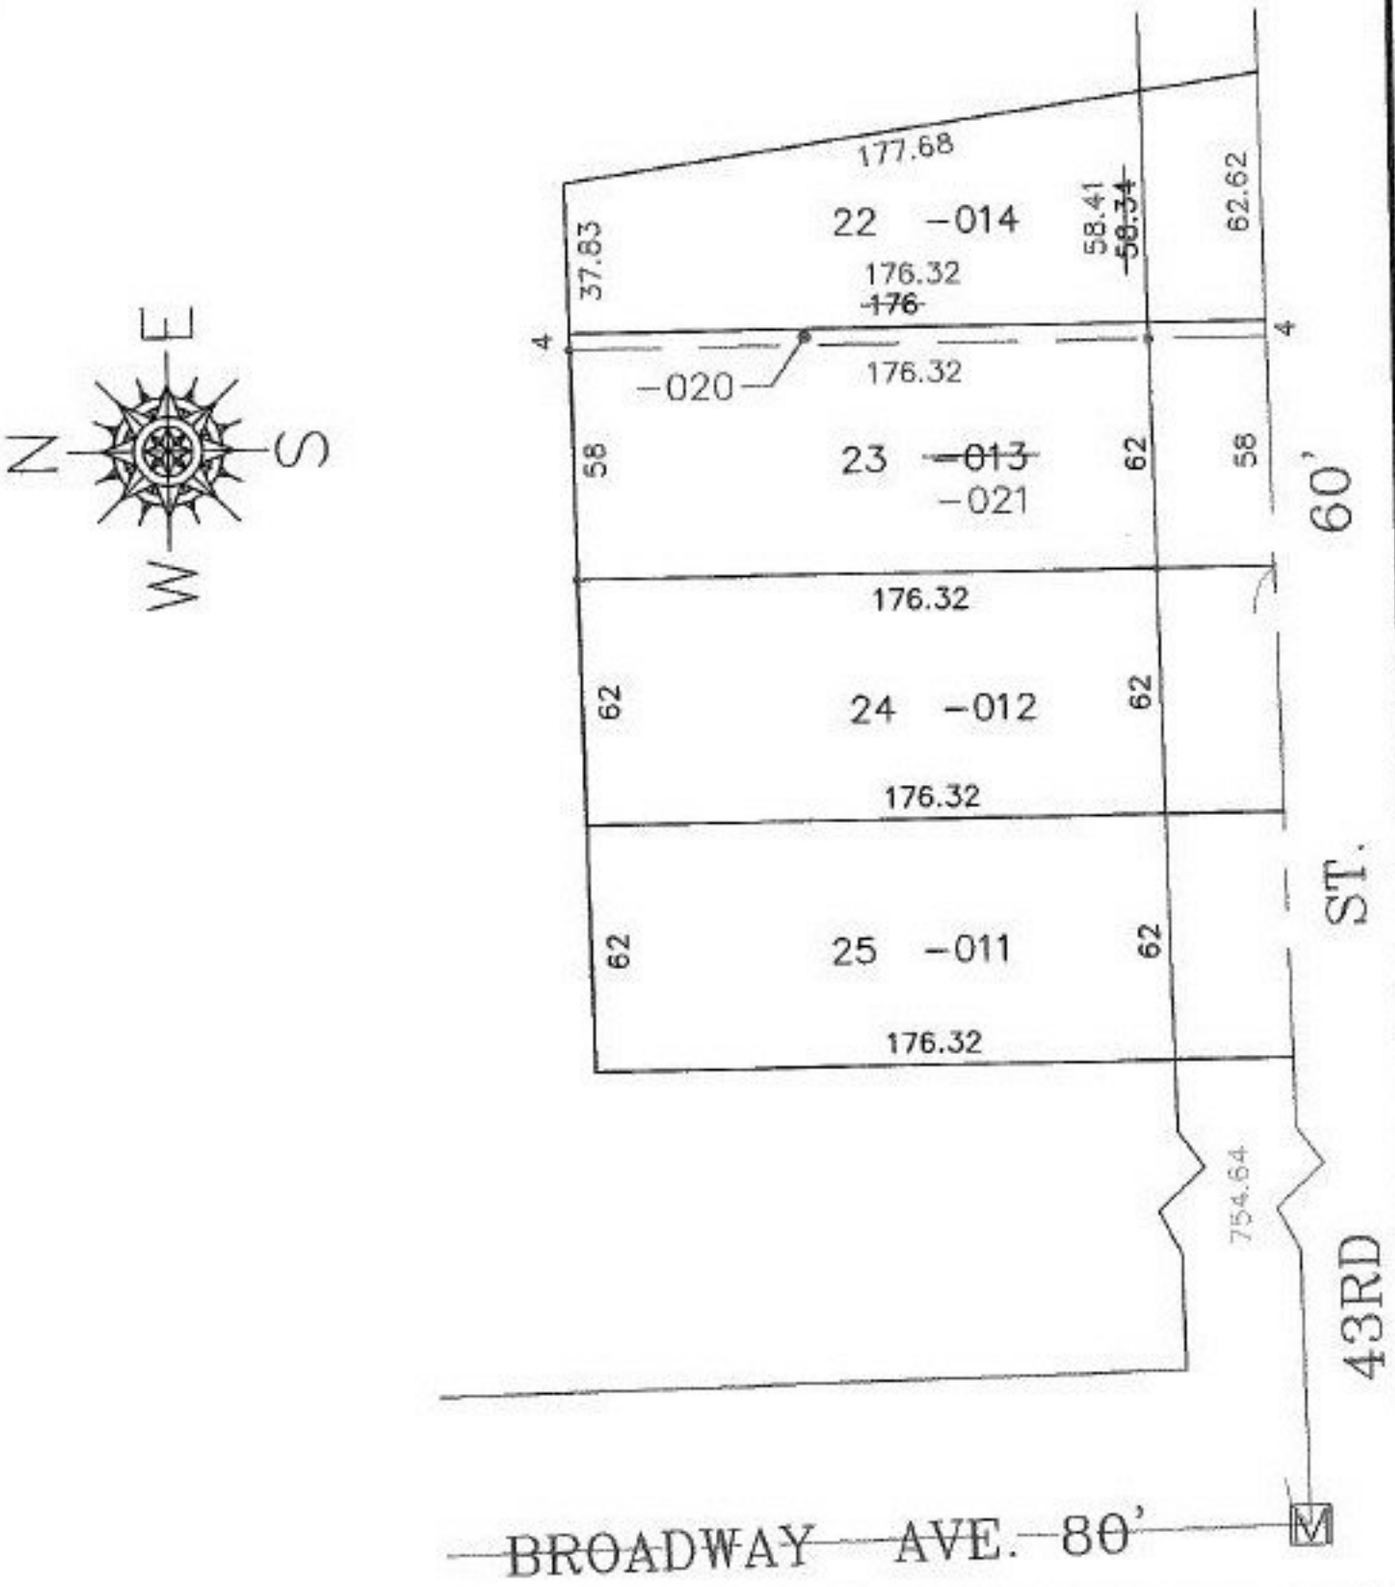

SPLITS/DEEDS PROCESSED
LORAIN COUNTY TAX MAP DEPARTMENT
226 MIDDLE AVE. ELYRIA, OHIO

SURVEYED BY: THOMAS A. SIMON
CLOSURE: 0.00 : 10,000
MAP PAGE(S): 03-00-108-A
APPROVED BY: TJS DATE: 12/29/00
SCALE: 1" = 50' PRIOR INSTRUMENT: 199905649B3