RASTER

PARENT PARCEL: 04-00-027-104-012
CHILD PARCEL: 04-00-027-104-013, -014
STARTING POINT: CENTERLINE OF CHERRY ST. & LEAR NAGLE RD.

NO. 00636

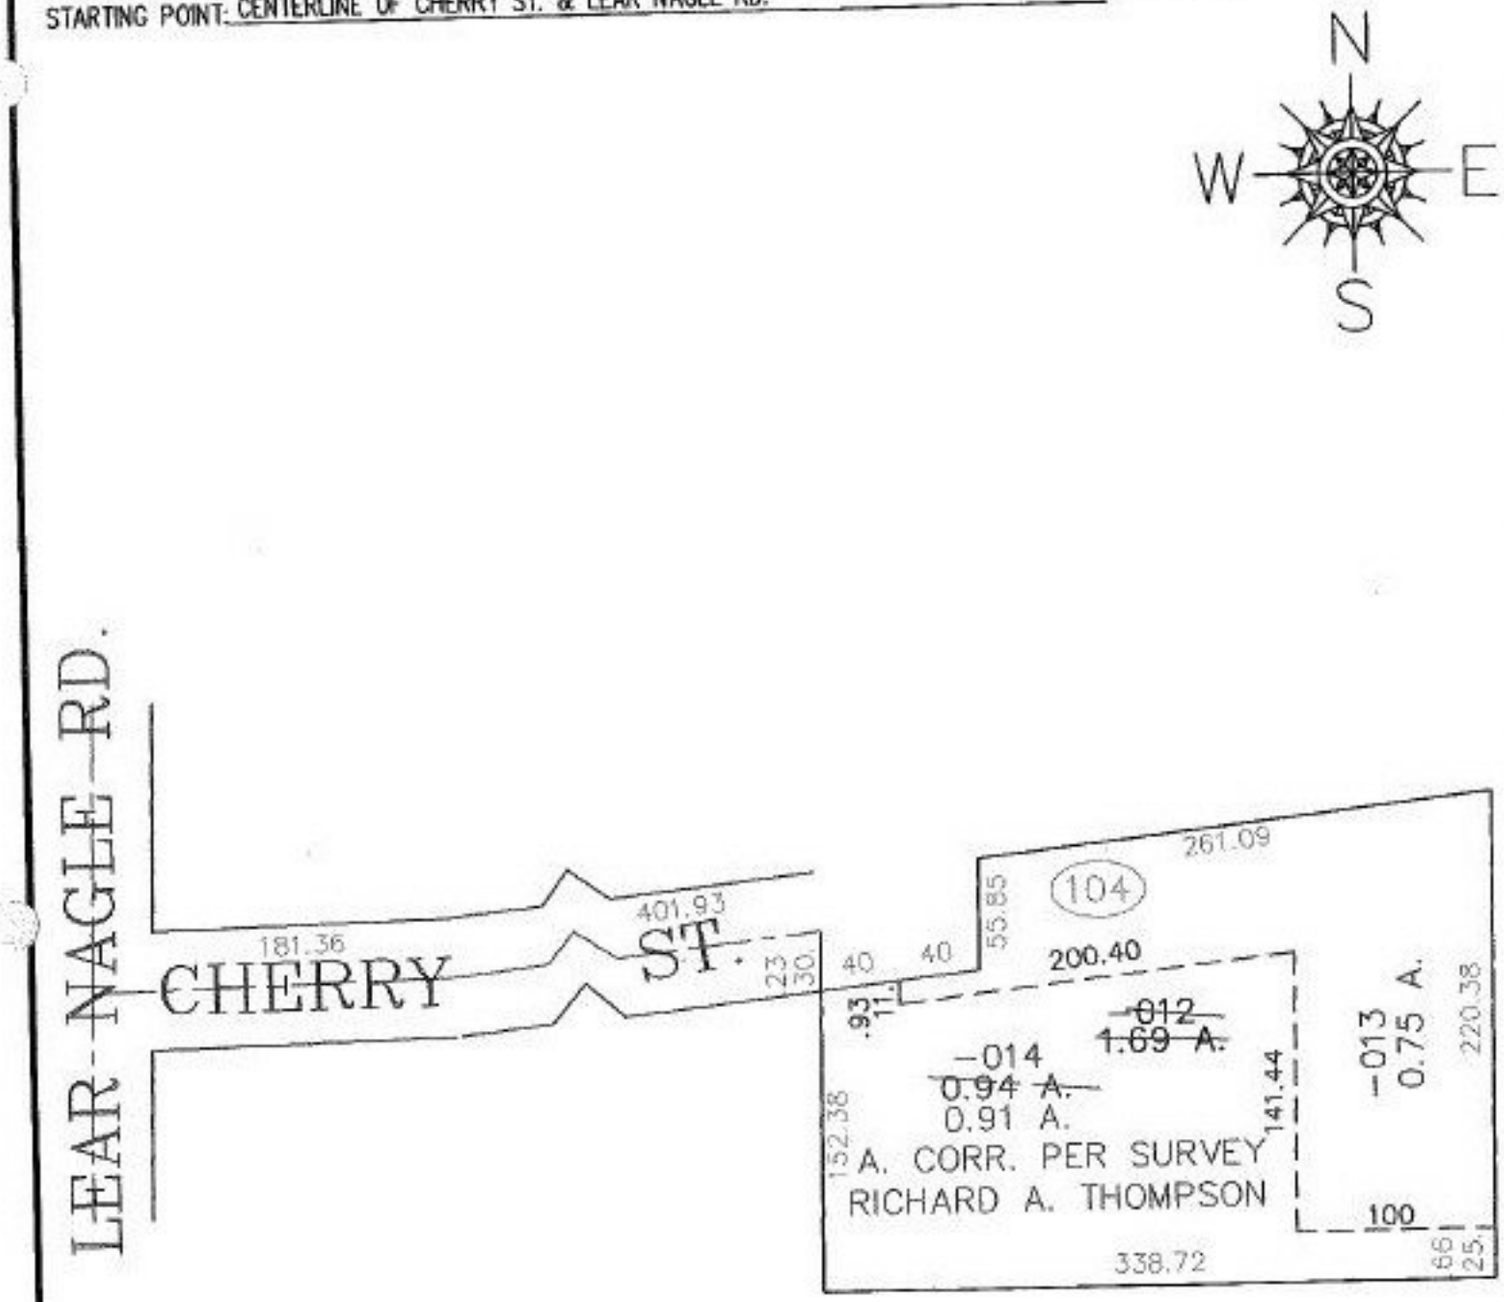

SPLITS/DEEDS PROCESSED

LORAIN COUNTY TAX MAP DEPARTMENT
226 MIDDLE AVE. ELYRIA, OHIO

SURVEYED BY: RICHARD A. THOMPSON
CLOSURE: 0.01 : 10,000
MAP PAGE(S): 4-00-027-F
APPROVED BY: JAH DATE: 1-8-01
SCALE: 1"= 100 PRIOR INSTRUMENT: OR 14/24