RASTER

PARENT PARCEL: 04-00-023-102-028
CHILD PARCEL: 04-00-023-102-029, -030 & 04-00-014-107-182
STARTING POINT: CL OF SCHWARTZ RD. & CL OF JAYCOX RD.

NO. 00640

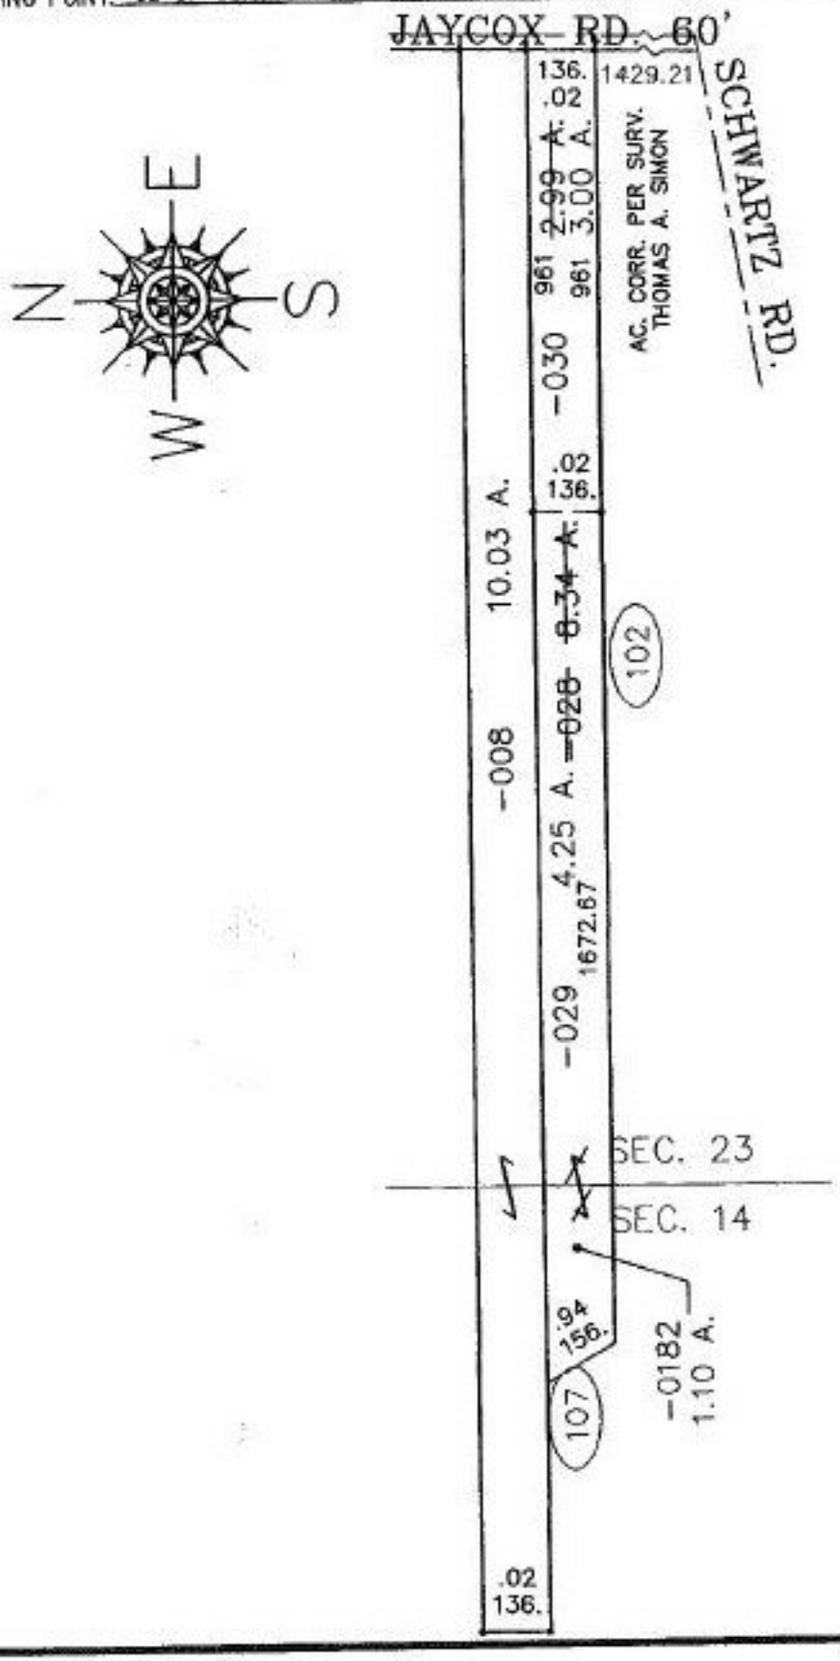

SPLITS/DEEDS PROCESSED

LORAIN COUNTY TAX MAP DEPARTMENT
226 MIDDLE AVE. ELYRIA, OHIO

SURVEYED BY: THOMAS A. SIMON
CLOSURE: 0.00 : 10,000
MAP PAGE(S): 04-00-014-D & 04-00-023-A&B
APPROVED BY: TJS DATE: 01/04/01
SCALE: 1"= 400 PRIOR INSTRUMENT: DV 635/460