RASTER

PARENT PARCEL: 18-00-043-000-056, -023
CHILD PARCEL: 18-00-043-000-058 THRU -060
STARTING POINT: CENTERLINE OF QUARRY RD. & PECK WADSWORH RD.

NO. 00643

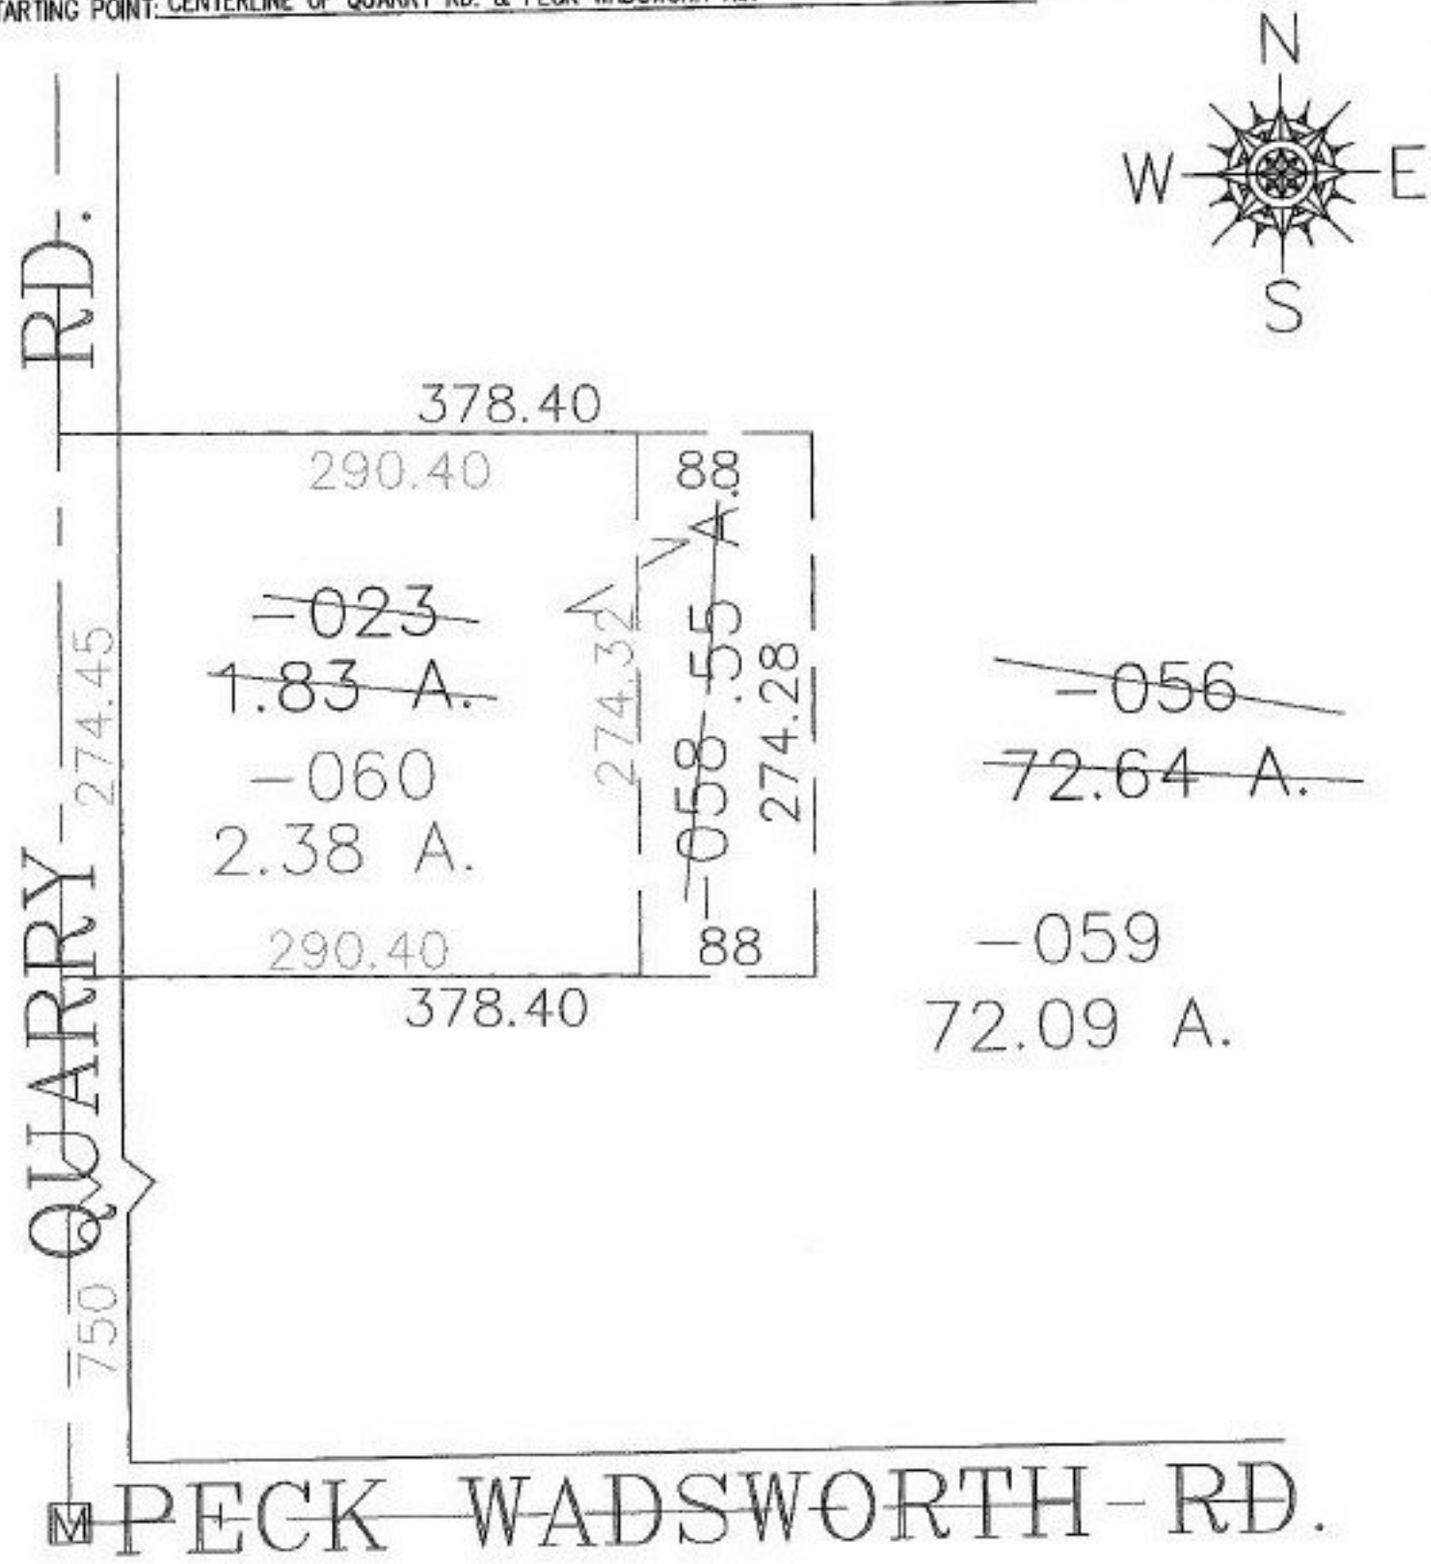

SPLITS/DEEDS PROCESSED

LORAIN COUNTY TAX MAP DEPARTMENT
226 MIDDLE AVE. ELYRIA, OHIO

SURVEYED BY: THOMAS A. SIMON
CLOSURE: 0.01 : 10,000
MAP PAGE(S): 18-00-043-C
APPROVED BY: JAH DATE: 1-5-01
SCALE: 1"= 100 PRIOR INSTRUMENT: OR 1079/31