RASTER

PARENT PARCEL: 10-00-001-101-076 THRU -079
CHILD PARCEL: 10-00-001-101--081 THRU -097
STARTING POINT: CENTERLINES OF RUSSIA RD. & WEST RIDGE RD.

NO. 00645

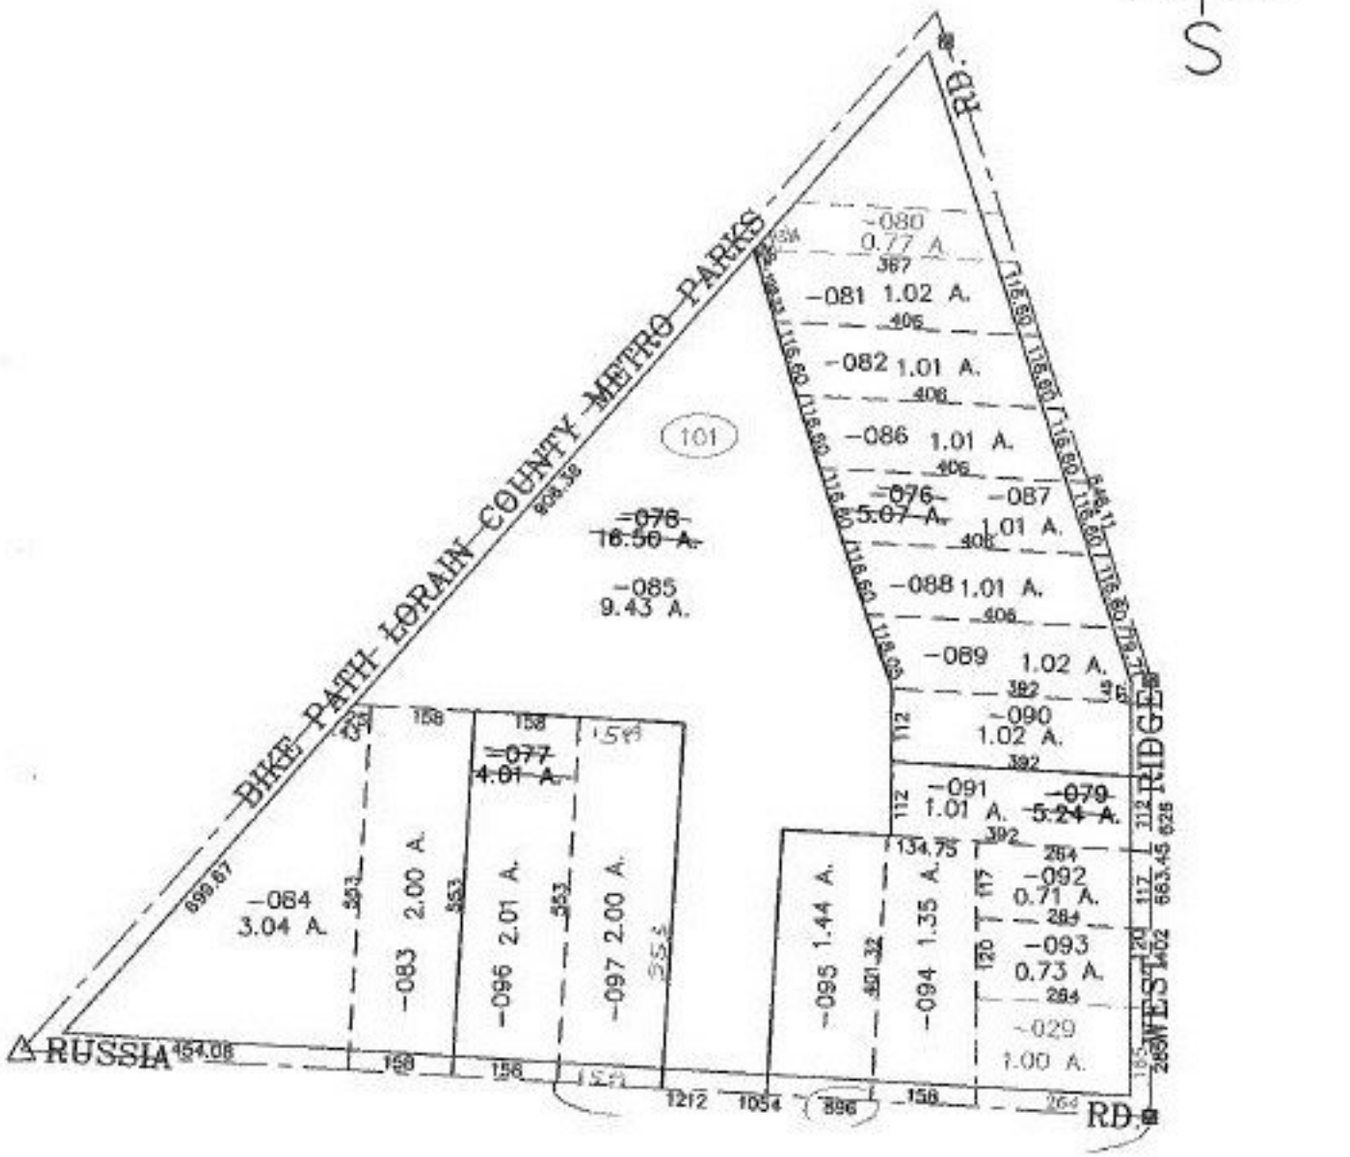

SPLITS/DEEDS PROCESSED
LORAIN COUNTY TAX MAP DEPARTMENT
226 MIDDLE AVE. ELYRIA, OHIO

SURVEYED BY: DAVID L. ELWELL
CLOSURE: 0.02 : 10,000
MAP PAGE(S): 10-00-001-G
APPROVED BY: JAH DATE: 01-24-01
SCALE: 1"= 300 PRIOR INSTRUMENT: 716932