RASTER

PARENT PARCEL: 04-00-002-101-054

CHILD PARCEL: 04-00-002-101-076, -077

STARTING POINT: CENTERLINE OF MOON RD. & DETROIT RD.

NO. 00648

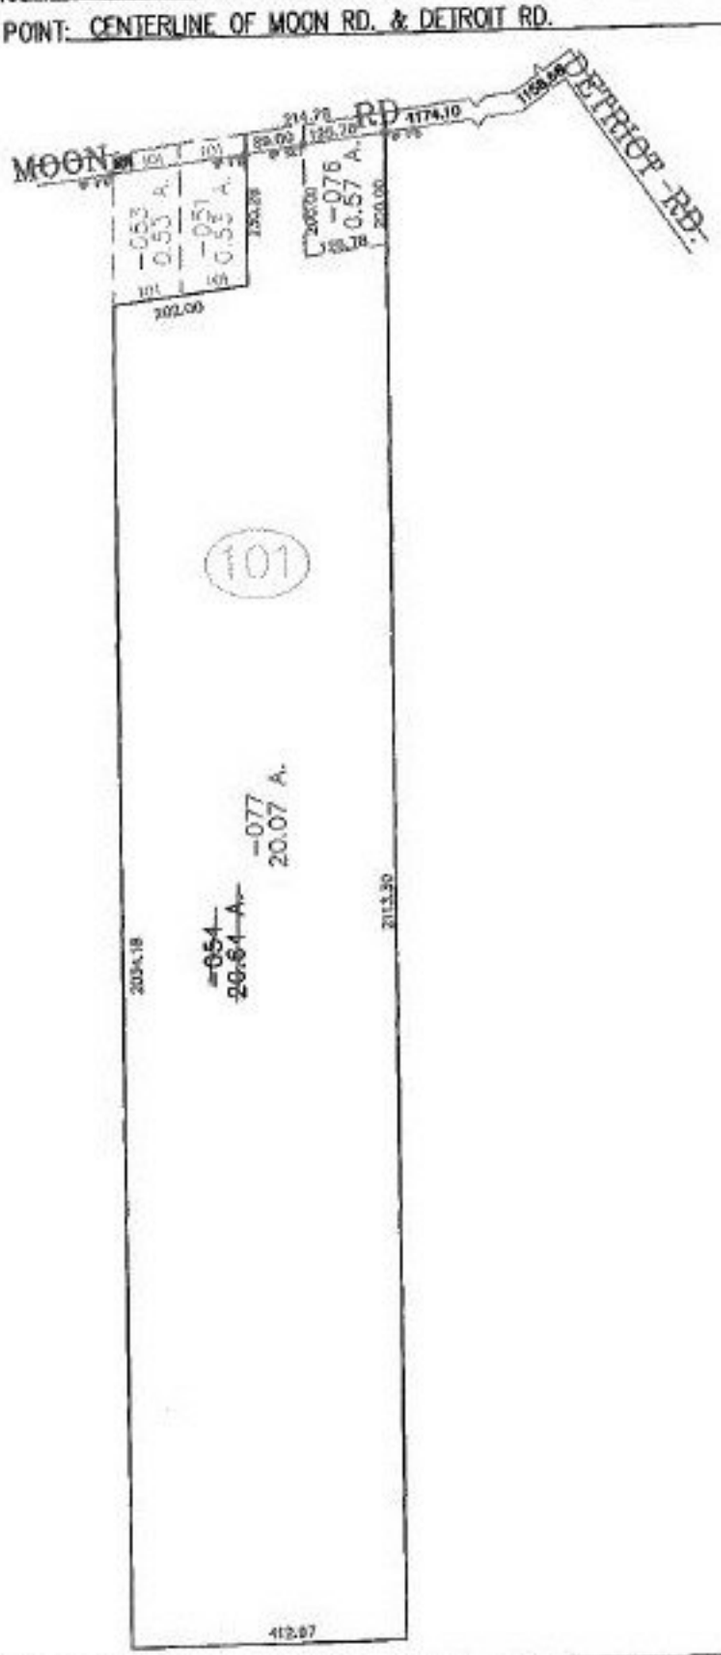

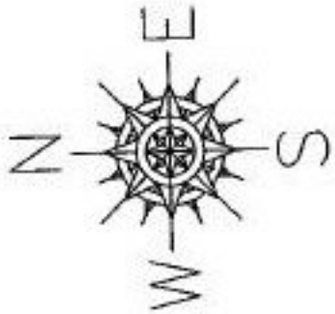

SHEET 2 OF 2

SPLITS/DEEDS PROCESSED

LORAIN COUNTY TAX MAP DEPARTMENT
226 MIDDLE AVE. ELYRIA, OHIO

SURVEYED BY: KATHLEEN A. MCGERVEY

CLOSURE: 0.00 : 10.000

MAP PAGE(S): 04-00-002-f

APPROVED BY: JAH DATE: 1-25-01

SCALE: 1" = 300 PRIOR INSTRUMENT: