RASTER

PARENT PARCEL: 06-25-021-106-049
CHILD PARCEL: 06-25-021-106-082, -083
STARTING POINT: SIDELINE OF ABBE RD. & POPLAR ST.

NO. 00651

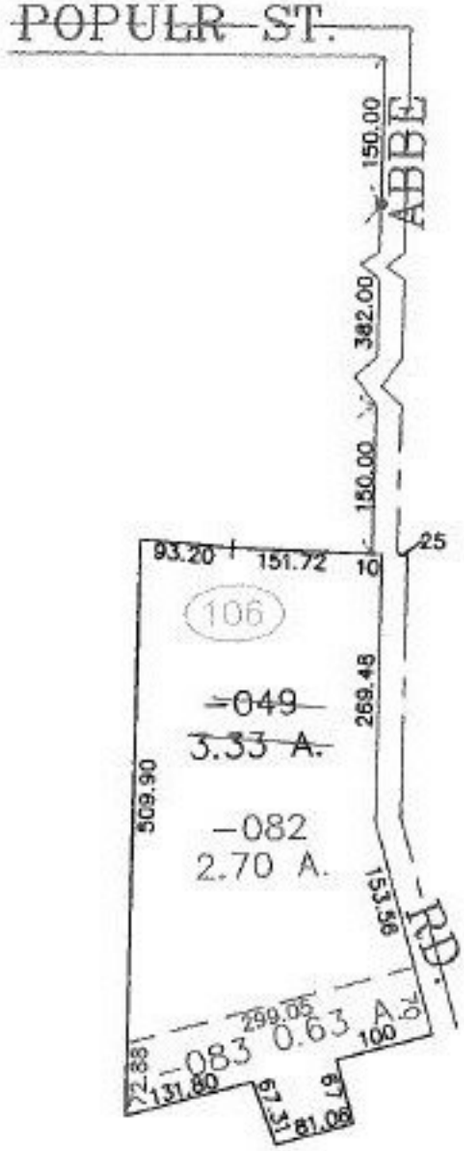

SPLITS/DEEDS PROCESSED
LORAIN COUNTY TAX MAP DEPARTMENT
226 MIDDLE AVE. ELYRIA, OHIO

SURVEYED BY: JAMES C. HARRINGTON
CLOSURE: 0.03 : 10,000
MAP PAGE(S): 6-88
APPROVED BY: JAH DATE: 01-26-01
SCALE: 1"= 200 PRIOR INSTRUMENT: OR 263/175