RASTER

PARENT PARCEL: 15-00-056-101-006, -054
CHILD PARCEL: 15-00-056-101-056, -057, -058
STARTING POINT: CENTERLINE OF WEST MAIN ST. & O.L. 56

NO. 00653

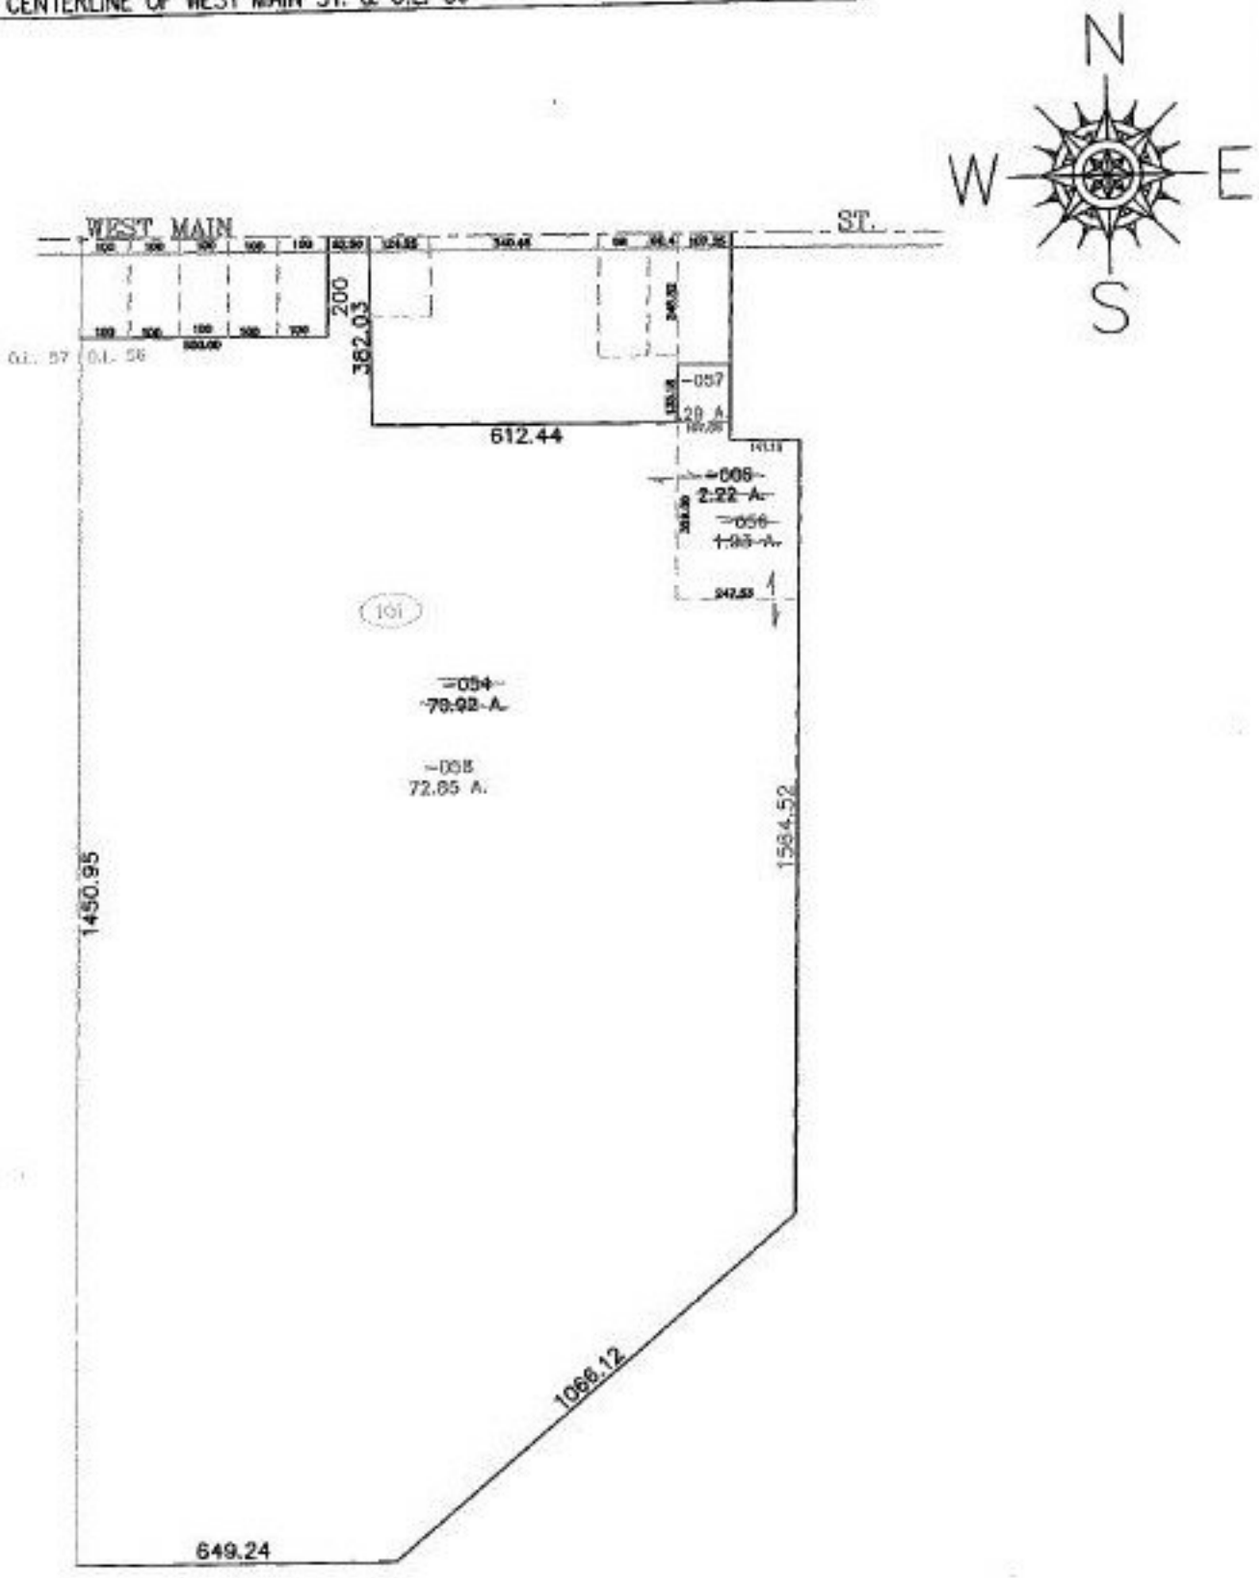

SPLITS/DEEDS PROCESSED
LORAIN COUNTY TAX MAP DEPARTMENT
226 MIDDLE AVE. ELYRIA, OHIO

SURVEYED BY: RODGER G. SIMON
CLOSURE: 0.01 : 10,000
MAP PAGE(S): 15-00-056-A, B
APPROVED BY: JAH DATE: 01-29-01
SCALE: 1"= 400 PRIOR INSTRUMENT: OR 1072/39