RASTER

PARENT PARCEL: 16-00-017-000-015, 16-00-024-000-012
CHILD PARCEL: 16-00-017-000-023 & -024, 16-00-024-000-013 THRU -020
STARTING POINT: I.P. , CL OF MENNELL RD. & S.W. CORNER OF O.L. 24

NO. 00658

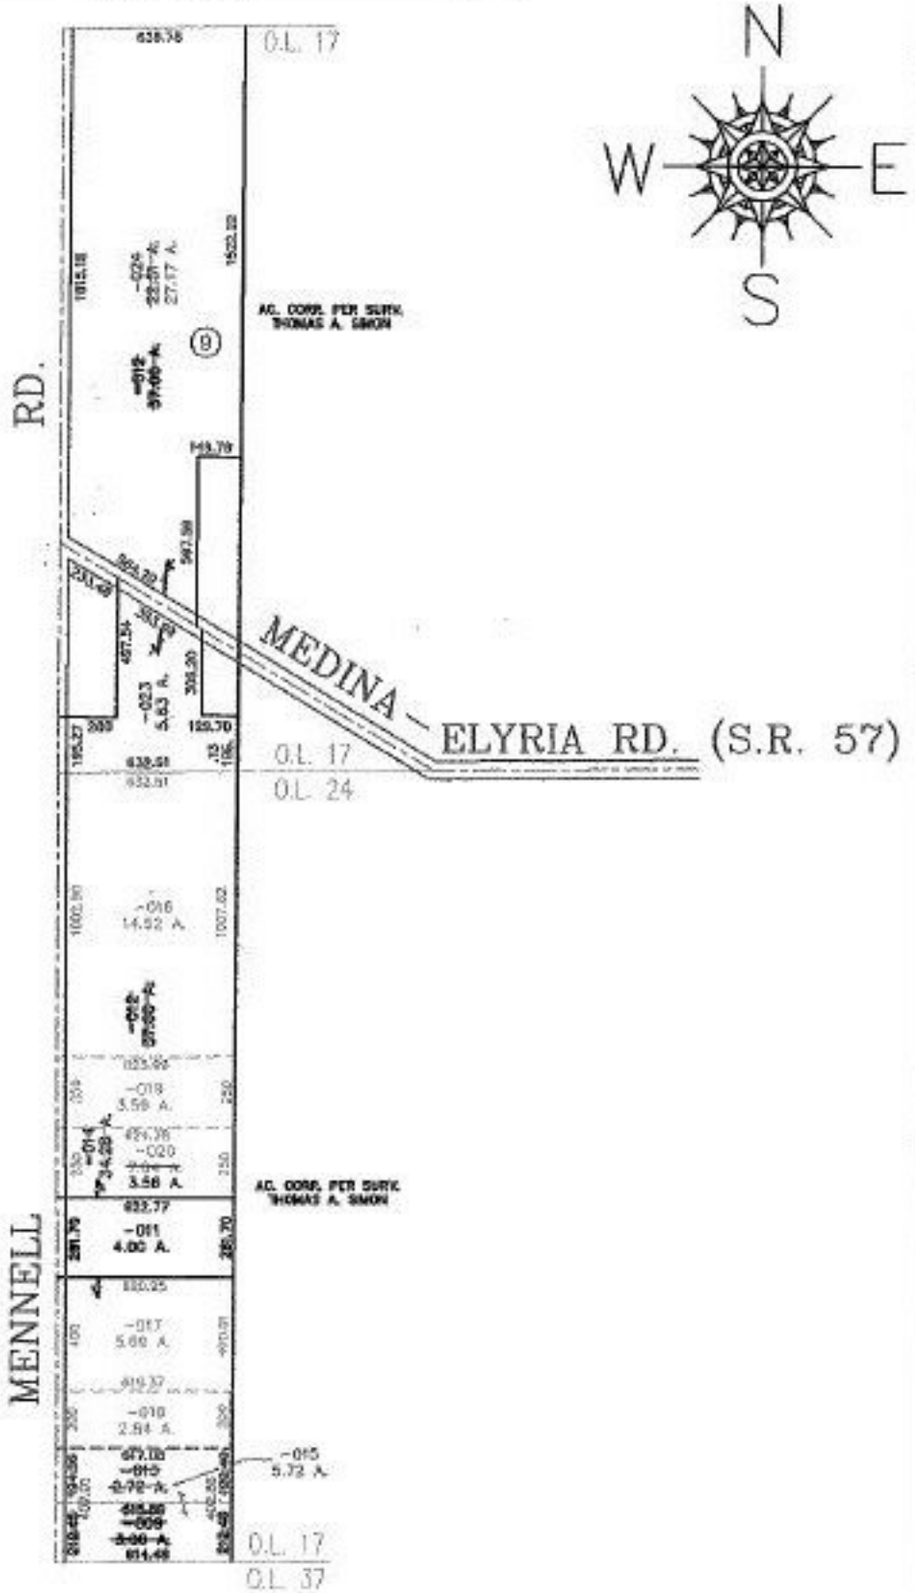


SPLITS/DEEDS PROCESSED

LORAIN COUNTY TAX MAP DEPARTMENT
226 MIDDLE AVE. ELYRIA, OHIO

SURVEYED BY: THOMAS A. SIMON
CLOSURE: 0.01 : 10,000
MAP PAGE(S): 16-B
APPROVED BY: TJS DATE: 02/13/01
SCALE: 1" = 700 PRIOR INSTRUMENT: 20010728466