RASTER

PARENT PARCEL: 15-00-035-000-110, -044
CHILD PARCEL: 15-00-035-000-112 thru -117
STARTING POINT: CENTERLINE OF NORTH CENTER ST. & BIGGS RD.

NO. 00668

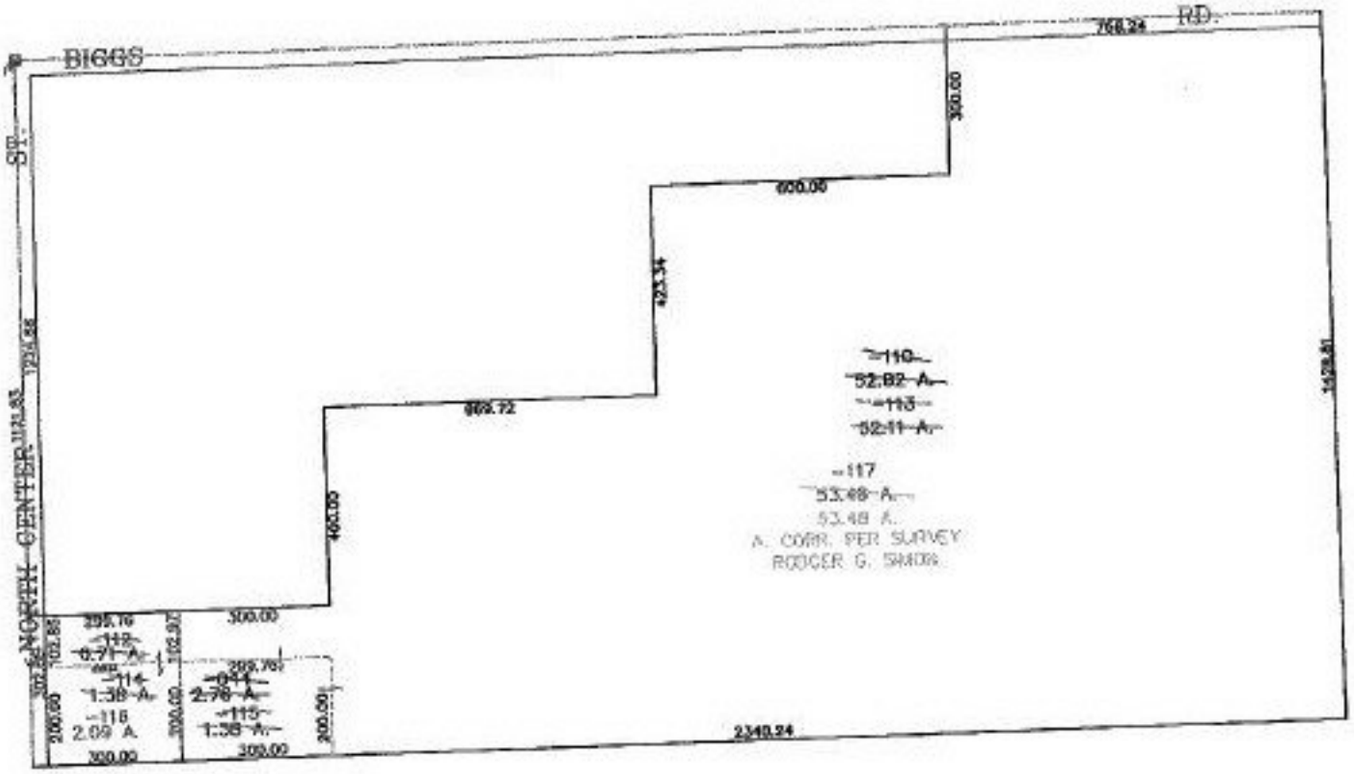

SPLITS/DEEDS PROCESSED
LORAIN COUNTY TAX MAP DEPARTMENT
226 MIDDLE AVE. ELYRIA, OHIO

SURVEYED BY: ROGGER G. SIMON
CLOSURE: 0.01 ; 10,000
MAP PAGE(S): 15-00-035-A, B
APPROVED BY: JAH DATE: 02-22-01
SCALE: 1"= 400 PRIOR INSTRUMENT: 200006633338