RASTER

PARENT PARCEL: 19-04-036-000-001, -004, 19-04-034-000-004

CHILD PARCEL: 19-04-036-000-005 thru -018, 19-04-034-000-028 thru -039

STARTING POINT: CENTERLINE OF MEDINA-NORWALK RD & FOSTER RD.

NO. 00670

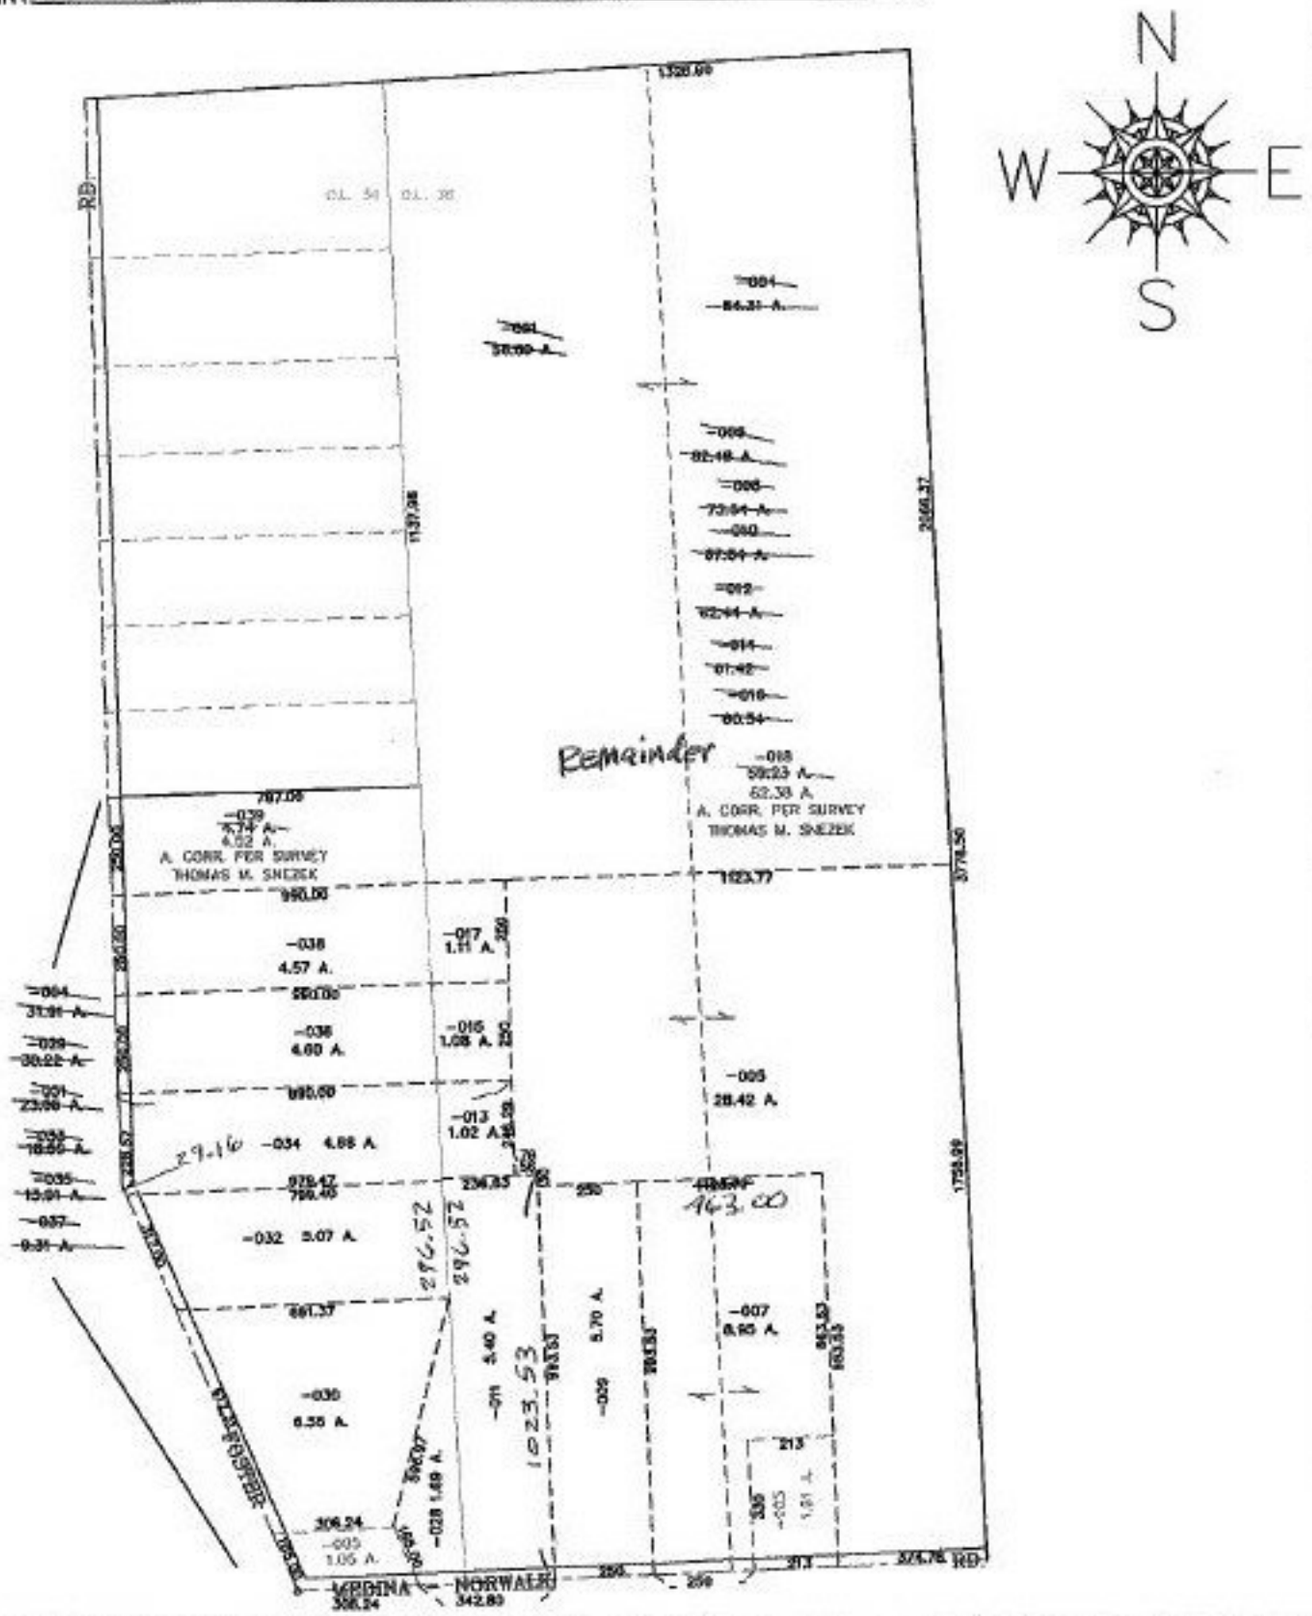

SPLITS/DEEDS PROCESSED

LORAIN COUNTY TAX MAP DEPARTMENT
226 MIDDLE AVE. ELYRIA, OHIO

SURVEYED BY: THOMAS M. SNEZEK
CLOSURE: 0.01 : 10,000
MAP PAGE(S): 19-C, 19-D
APPROVED BY: JAH DATE: 3-6-01
SCALE: 1" = 500 PRIOR INSTRUMENT: 990656789