PARENT PARCEL: 15-00-050-000-010

CHILD PARCEL: 15-00-050-000-011 & -012

STARTING POINT: 1" I.P. MON. BOX, CL OF S.R. 303 & CL OF CHAMBERLAIN RD. (STA 53+35.96) LOR-303-14.09

16-00735

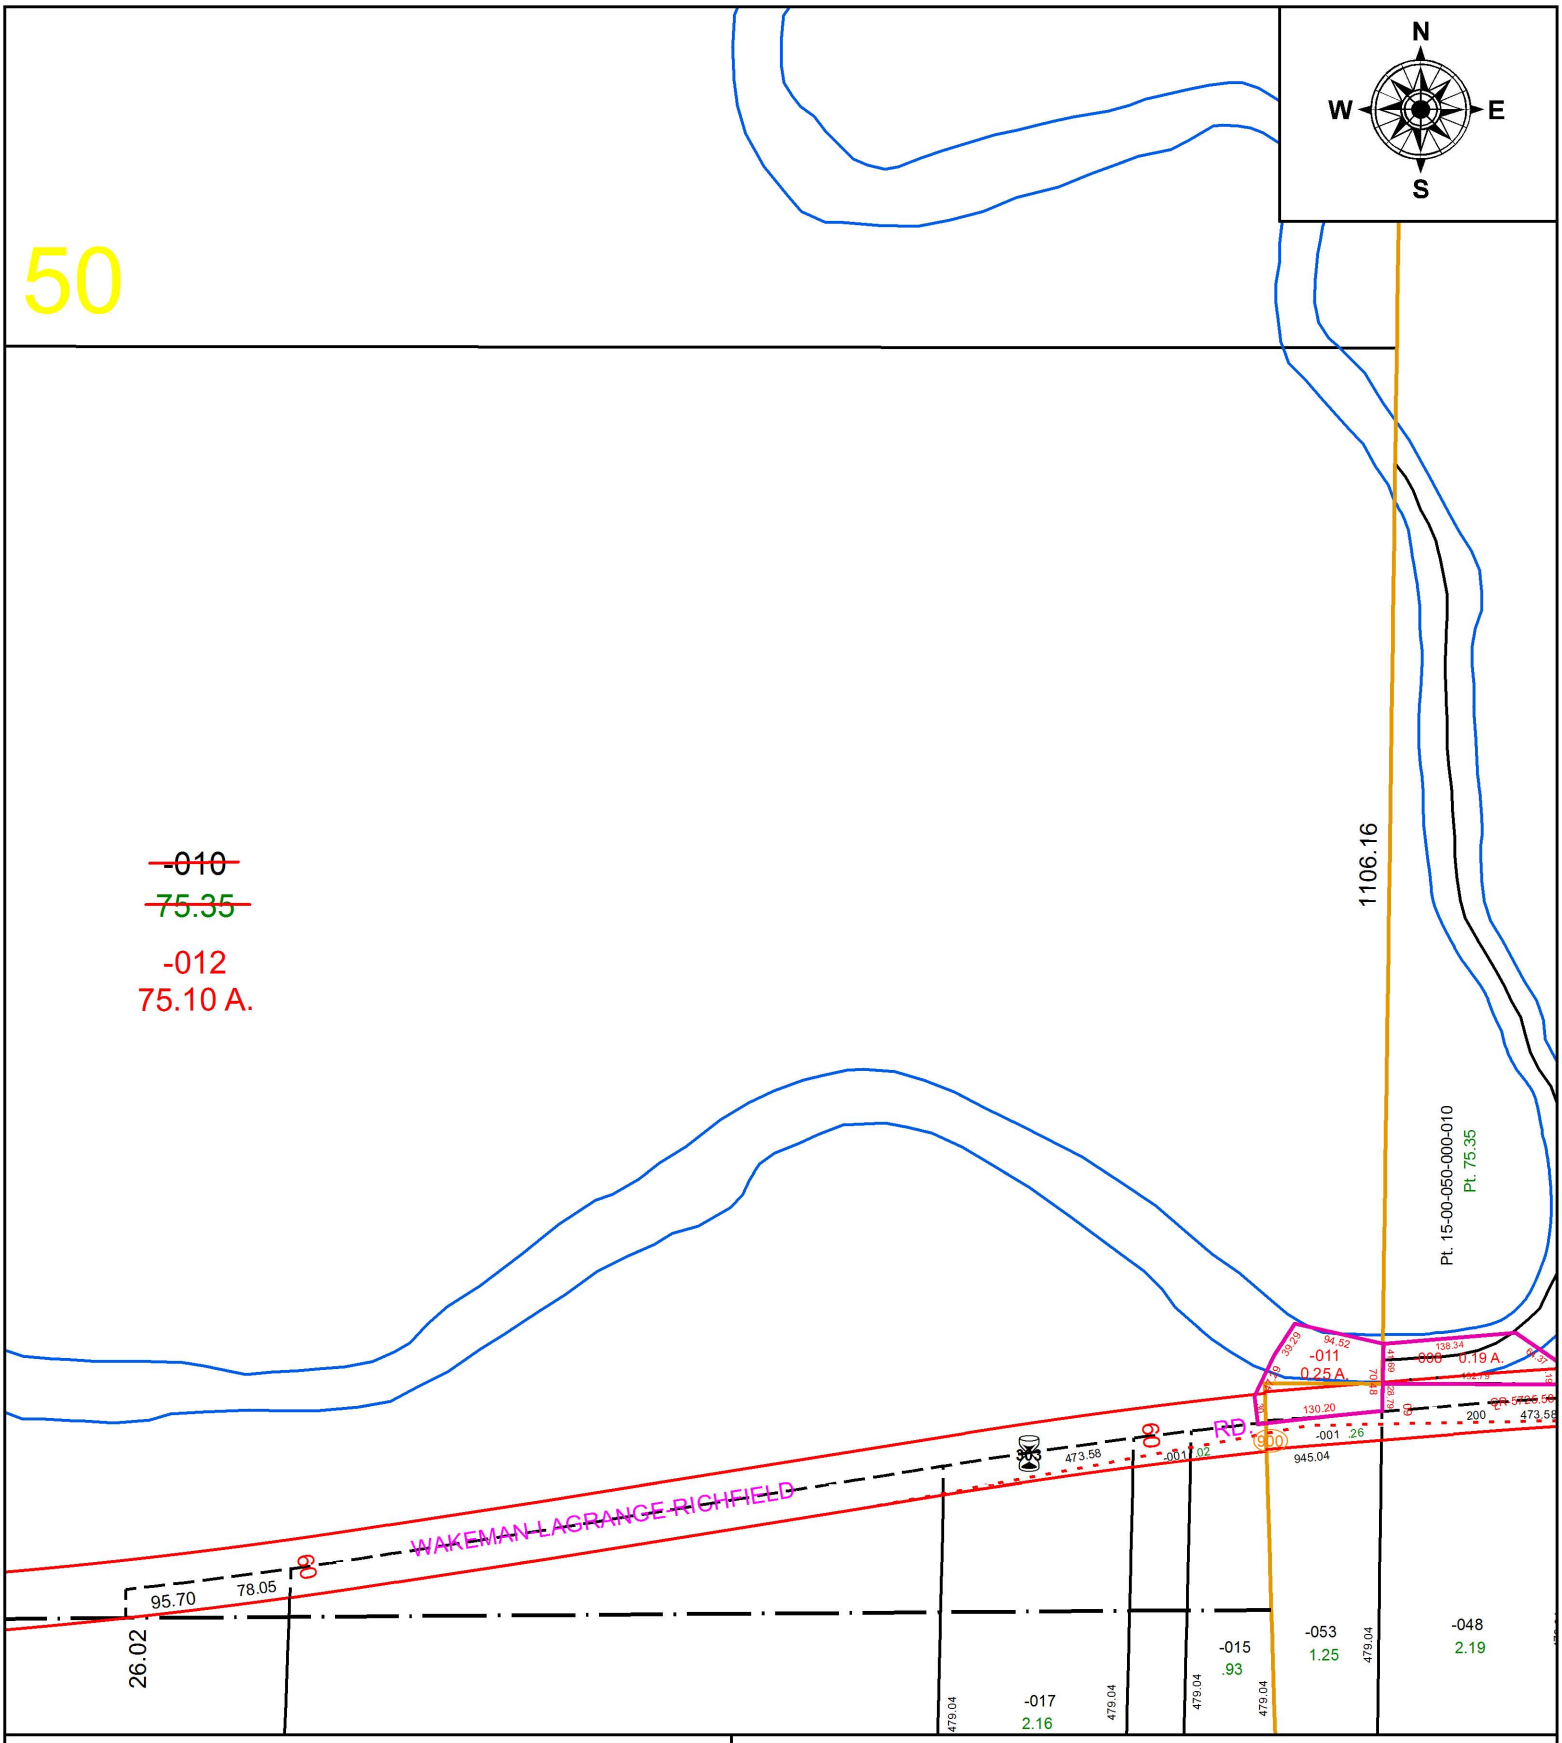

SPLITS/DEEDS PROCESSED

LORAIN COUNTY TAX MAP DEPARTMENT
226 MIDDLE AVE. ELYRIA, OH

SURVEYED BY: SCOTT HAWKINS
CLOSURE: 1: 33,000
MAP PAGE(S): 15-00-050
APPOVED BY: TJS **DATE:** 8/10/16
SCALE: 1" = 200 **PRIOR INSTRUMENT:** OR 626/282