PARENT PARCEL: 09-00-095-108-014
CHILD PARCEL: 09-00-095-108-070, -071
STARTING POINT: INTERSECTION OF C/L OF LINCOLN ST. AND C/L OF S. PROFESSOR ST.

16-00746

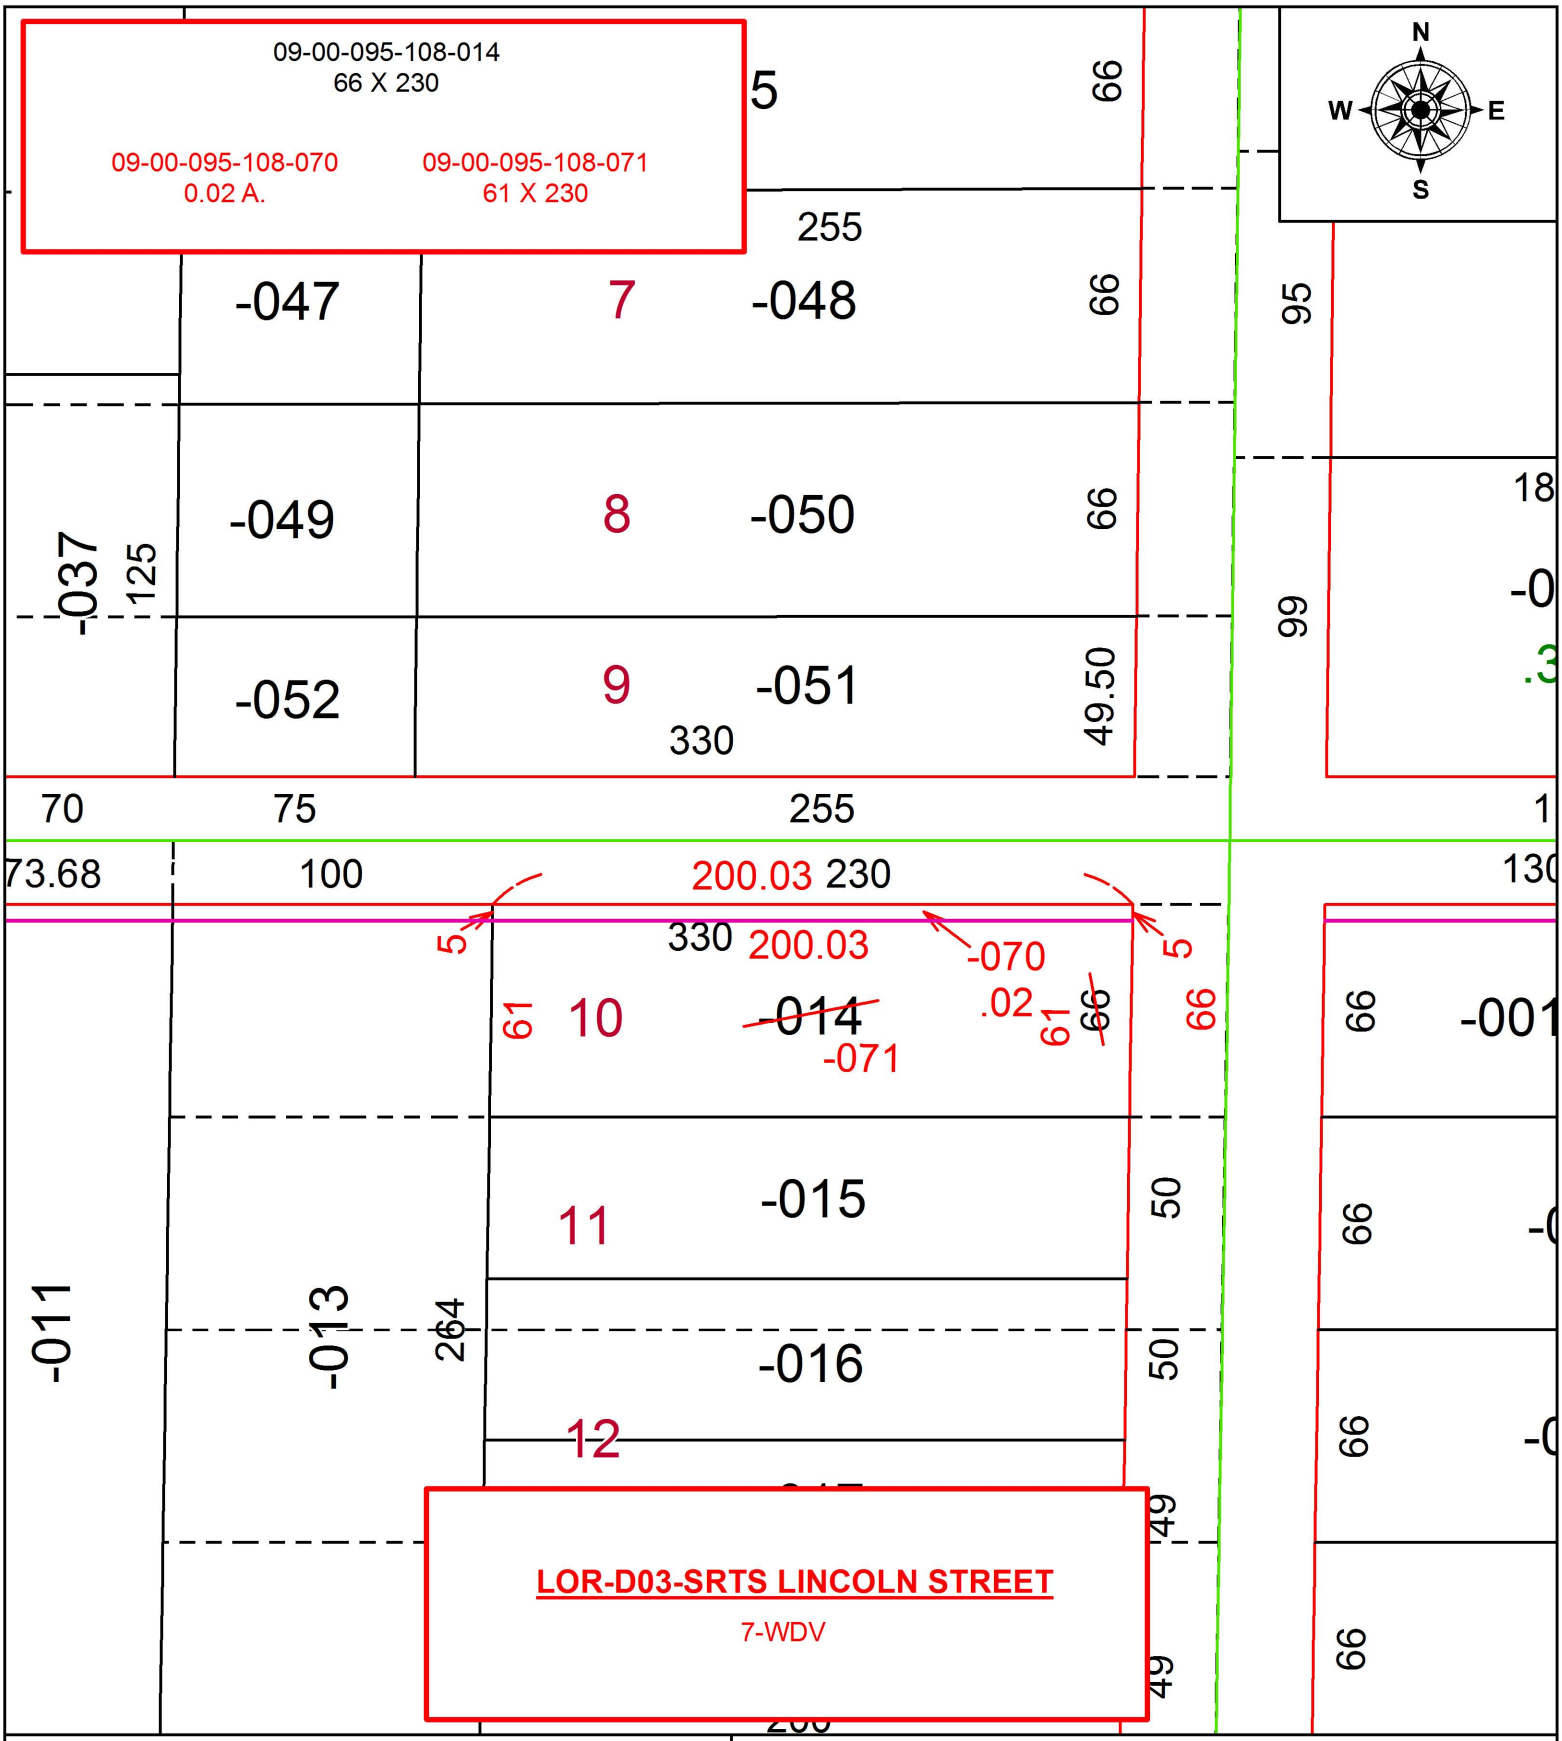

SPLITS/DEEDS PROCESSED
LORAIN COUNTY TAX MAP DEPARTMENT
226 MIDDLE AVE. ELYRIA, OH

SURVEYED BY: TREVOR A. BIXLER
CLOSURE: 1:167,487
MAP PAGE(S): 9-00-095
APPOVED BY: RRM **DATE:** 10-20-16
SCALE: 1" = 60 **PRIOR INSTRUMENT:** 20110385211