PARENT PARCEL: 09-00-095-107-002
CHILD PARCEL: 09-00-095-107-039, -040
STARTING POINT: INTERSECTION OF C/L OF LINCOLN ST. AND C/L OF S. PROFESSOR ST.

16-00748

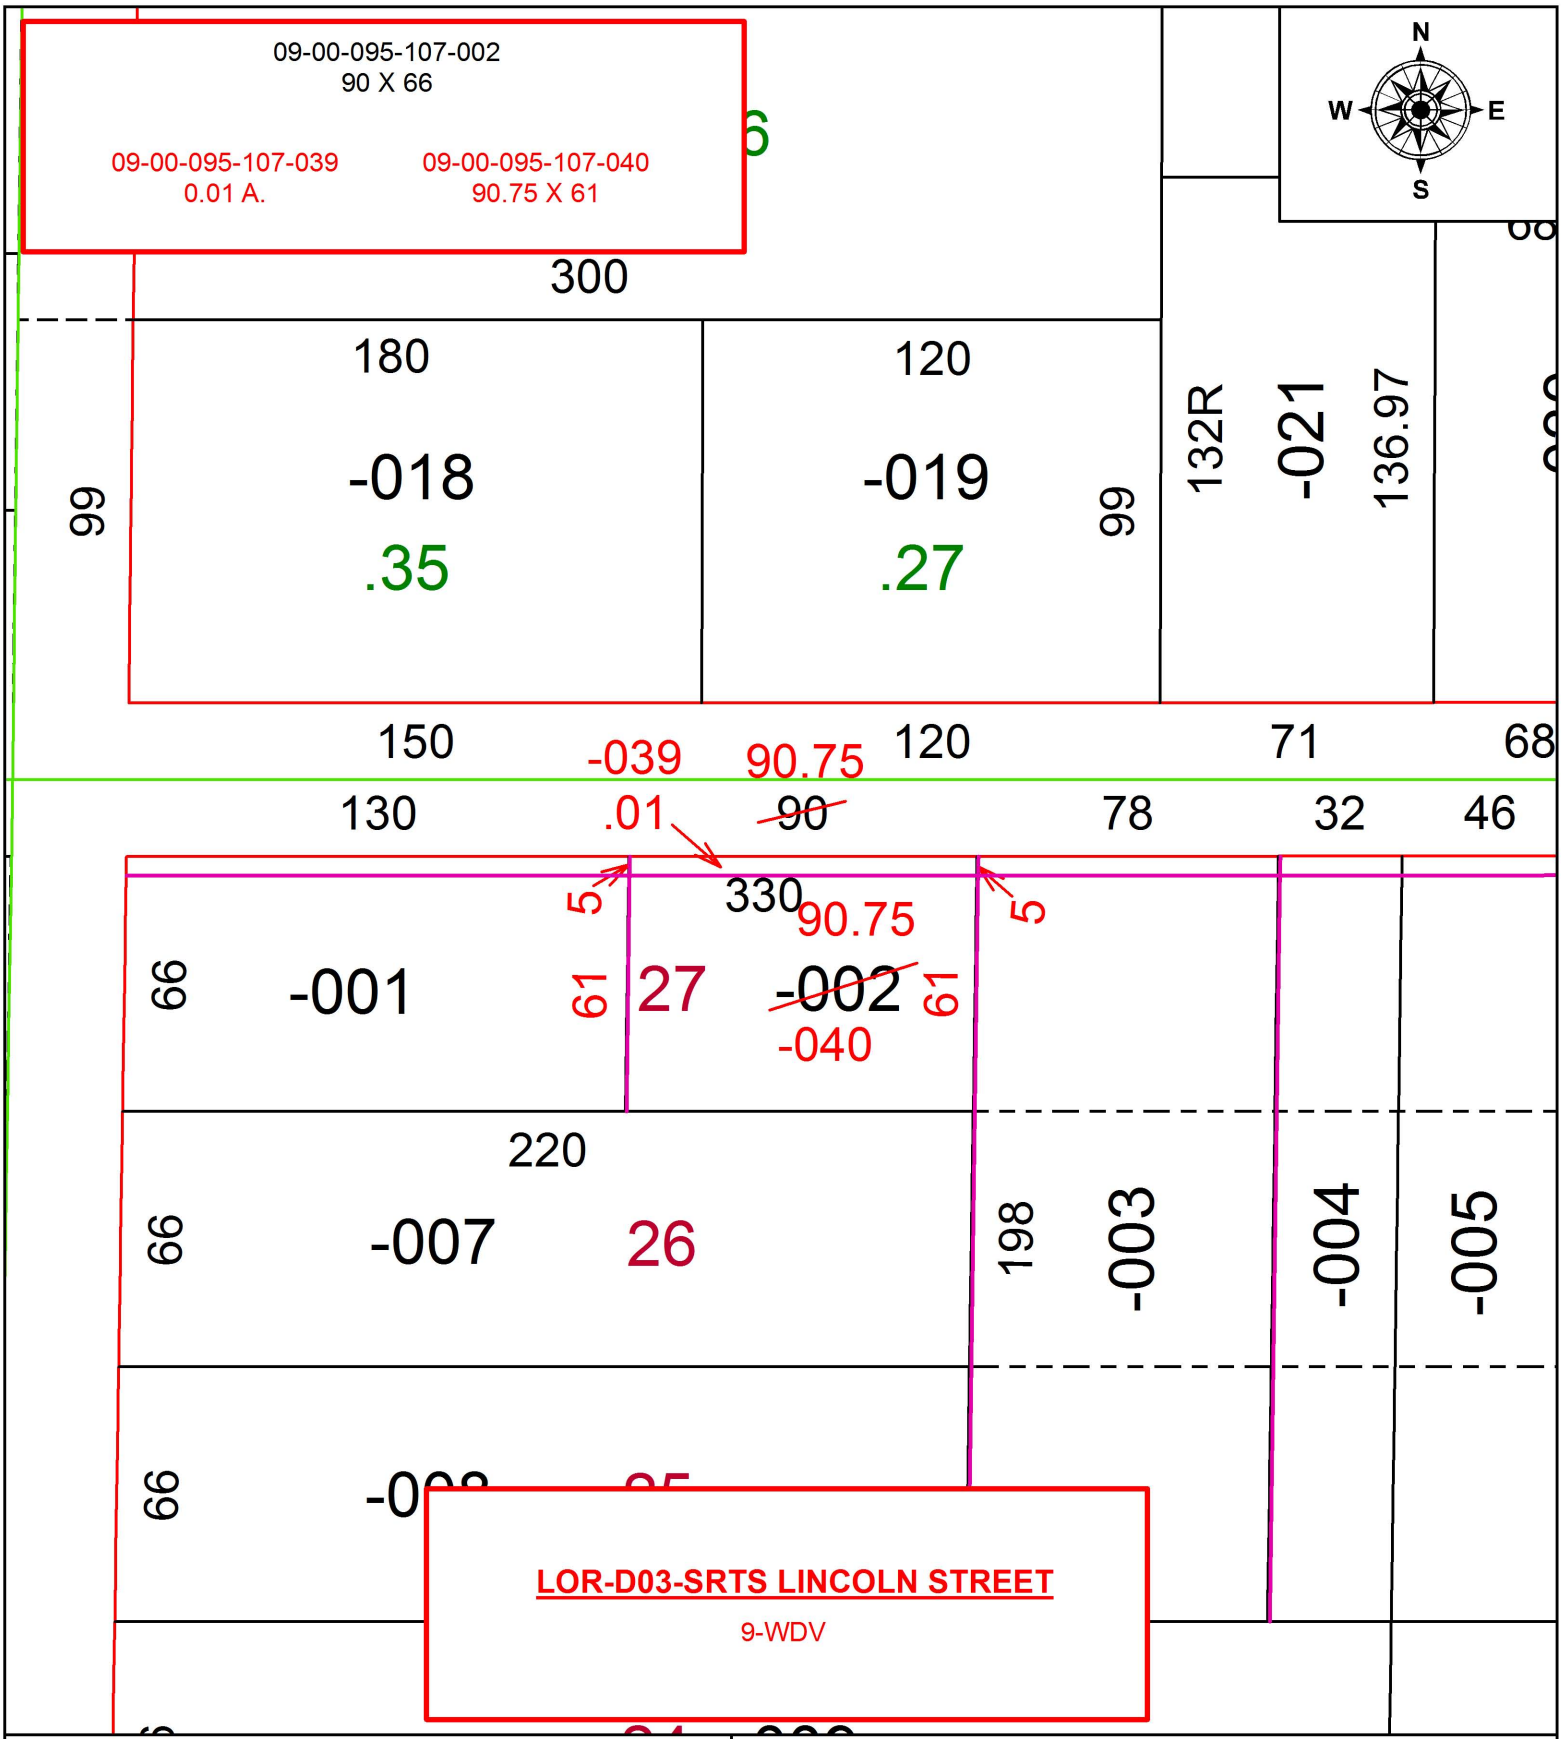

SPLITS/DEEDS PROCESSED
LORAIN COUNTY TAX MAP DEPARTMENT
226 MIDDLE AVE. ELYRIA, OH

SURVEYED BY: TREVOR A. BIXLER
CLOSURE: 1:48,383
MAP PAGE(S): 9-00-095
APPOVED BY: RRM **DATE:** 10-20-16
SCALE: 1" = 50 **PRIOR INSTRUMENT:** 20060152961