PARENT PARCEL: 05-00-007-000-025

CHILD PARCEL: 05-00-007-000-030, -031

STARTING POINT: INTERSECTION OF C/L OF QUARRY RD. AND C/L OF MIDDLE RIDGE RD.

18-00764

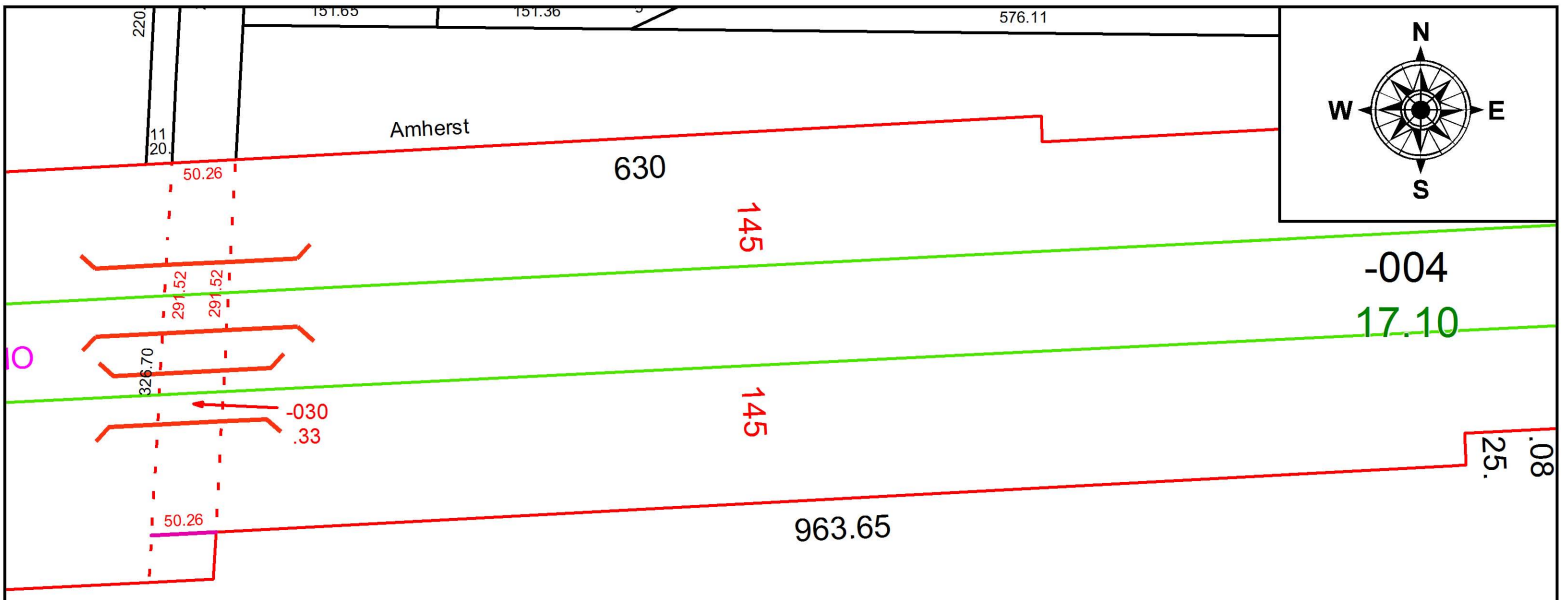

7

~~-025~~

~~103.34~~

-031

103.01

SPLITS/DEEDS PROCESSED

LORAIN COUNTY TAX MAP DEPARTMENT
226 MIDDLE AVE. ELYRIA, OH

SURVEYED BY: MICHAEL J. HUDIK
CLOSURE: 1: 241,826
MAP PAGE(S): 5-00-007
APPOVED BY: RRM **DATE:** 4-25-18
SCALE: 1" = 150 **PRIOR INSTRUMENT:** 20160607790