**PARENT PARCEL:** 16-00-001-107-021

**CHILD PARCEL:** 16-00-001-107-041, -042, & -043

**STARTING POINT:** SOUTH R.O.W. OF S.R. 57 & WEST R.O.W. OF MECHANIC ST.

21-00778

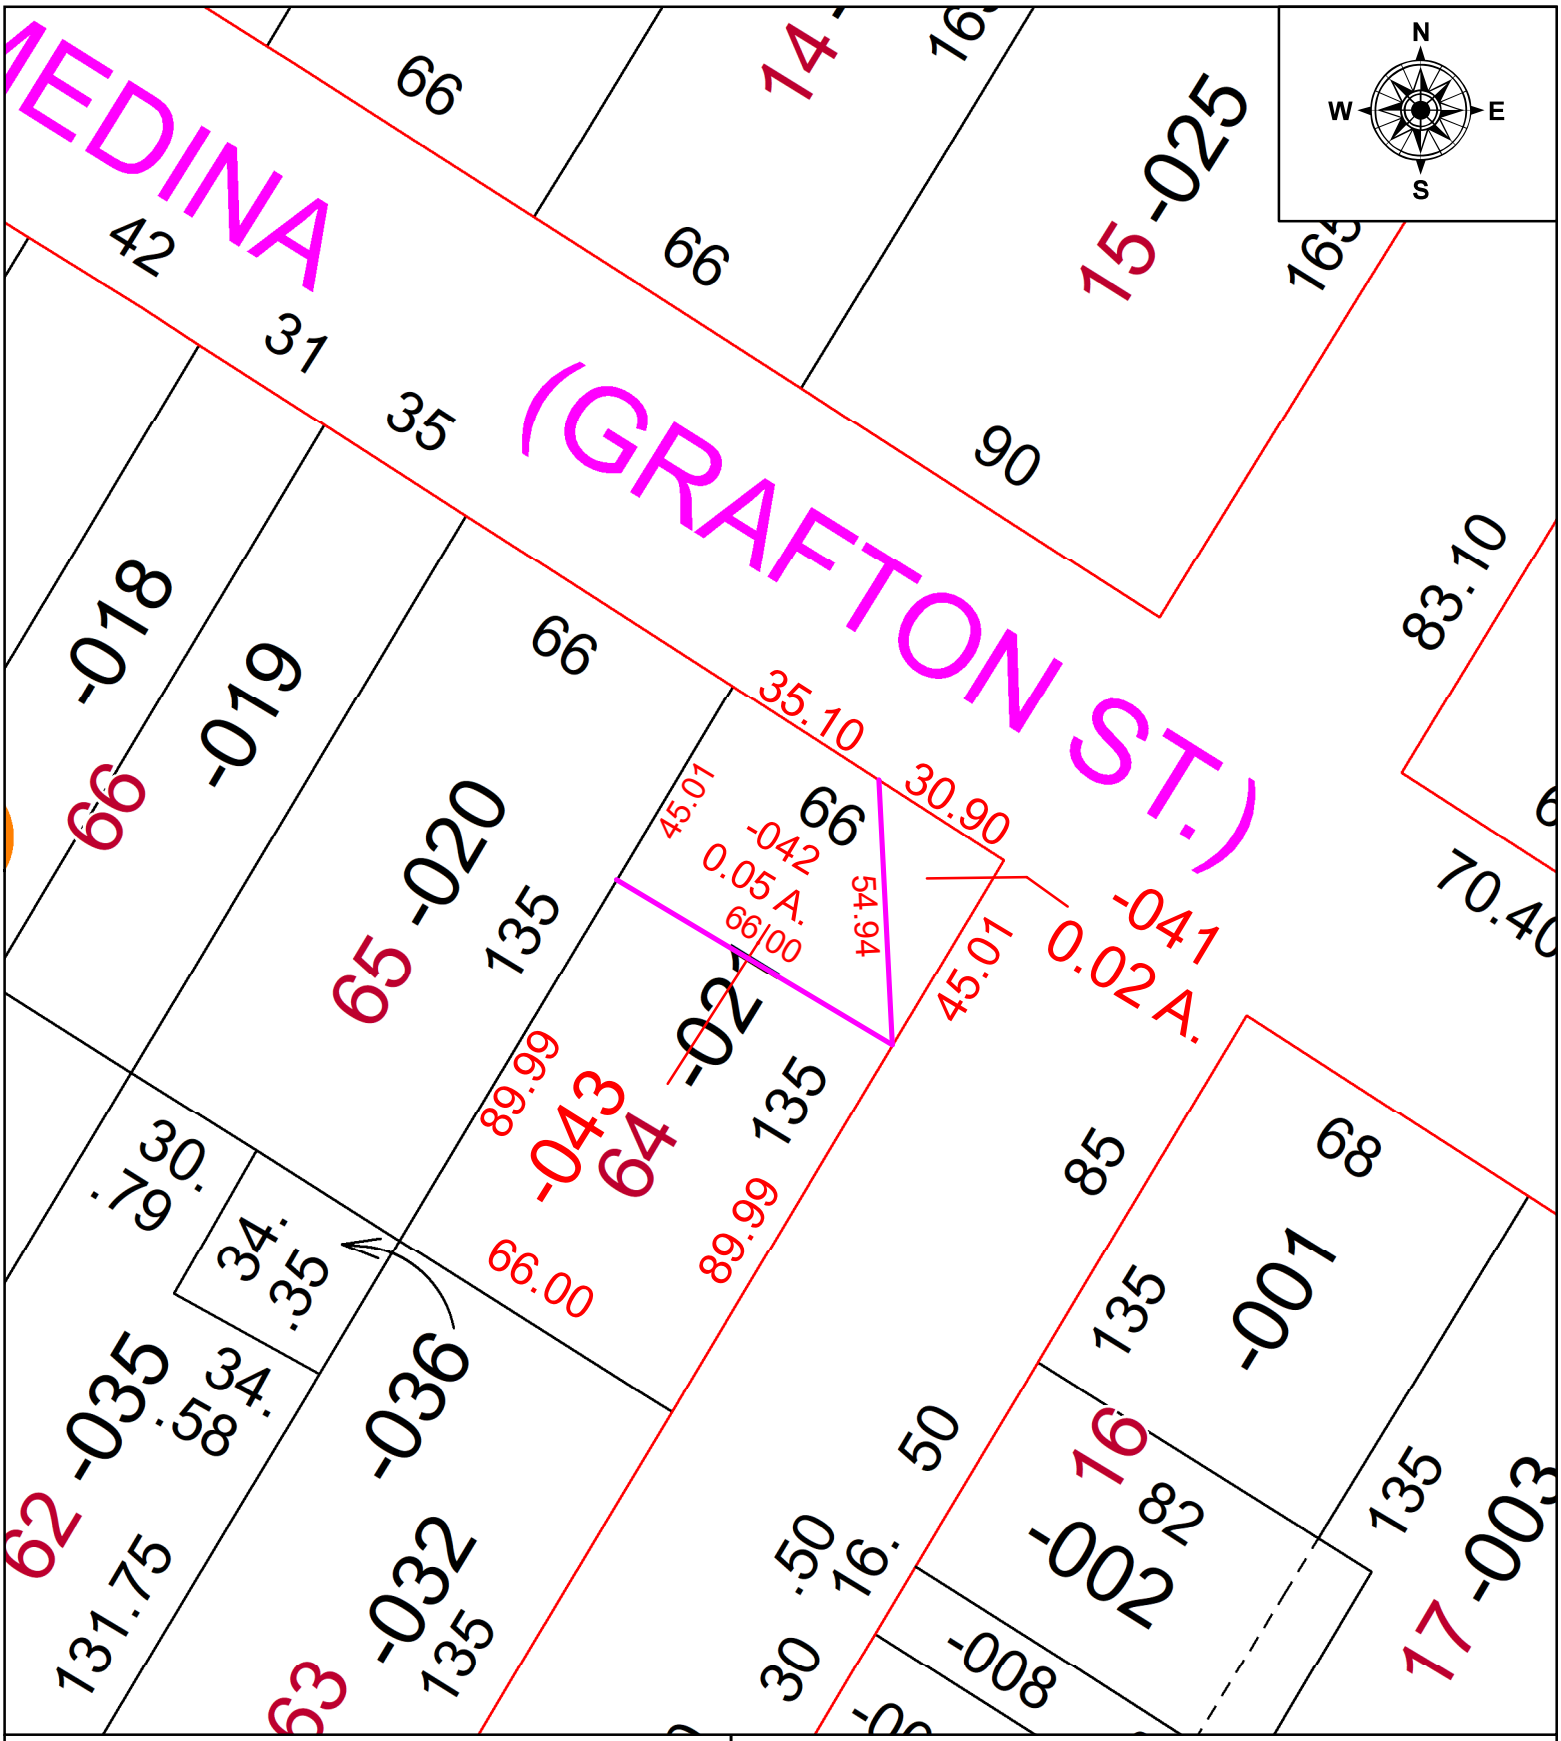


**SPLITS/DEEDS PROCESSED**

LORAIN COUNTY TAX MAP DEPARTMENT
226 MIDDLE AVE. ELYRIA, OH

**SURVEYED BY:** KEVIN CANAVAN
**CLOSURE:** 1:21452
**MAP PAGE(S):** 16-00-001
**APPOVED BY:** TJS **DATE:** 10/25/2021
**SCALE:** 1" = 40' **PRIOR INSTRUMENT:** 2019-0717846