PARENT PARCEL: 07-00-031-000-179 & -180
CHILD PARCEL: 07-00-031-000-352, -353, & -354
STARTING POINT: I.P. MON. BOX, CL OF STONEY RIDGE RD. & CL OF MILLS RD.

22-00783

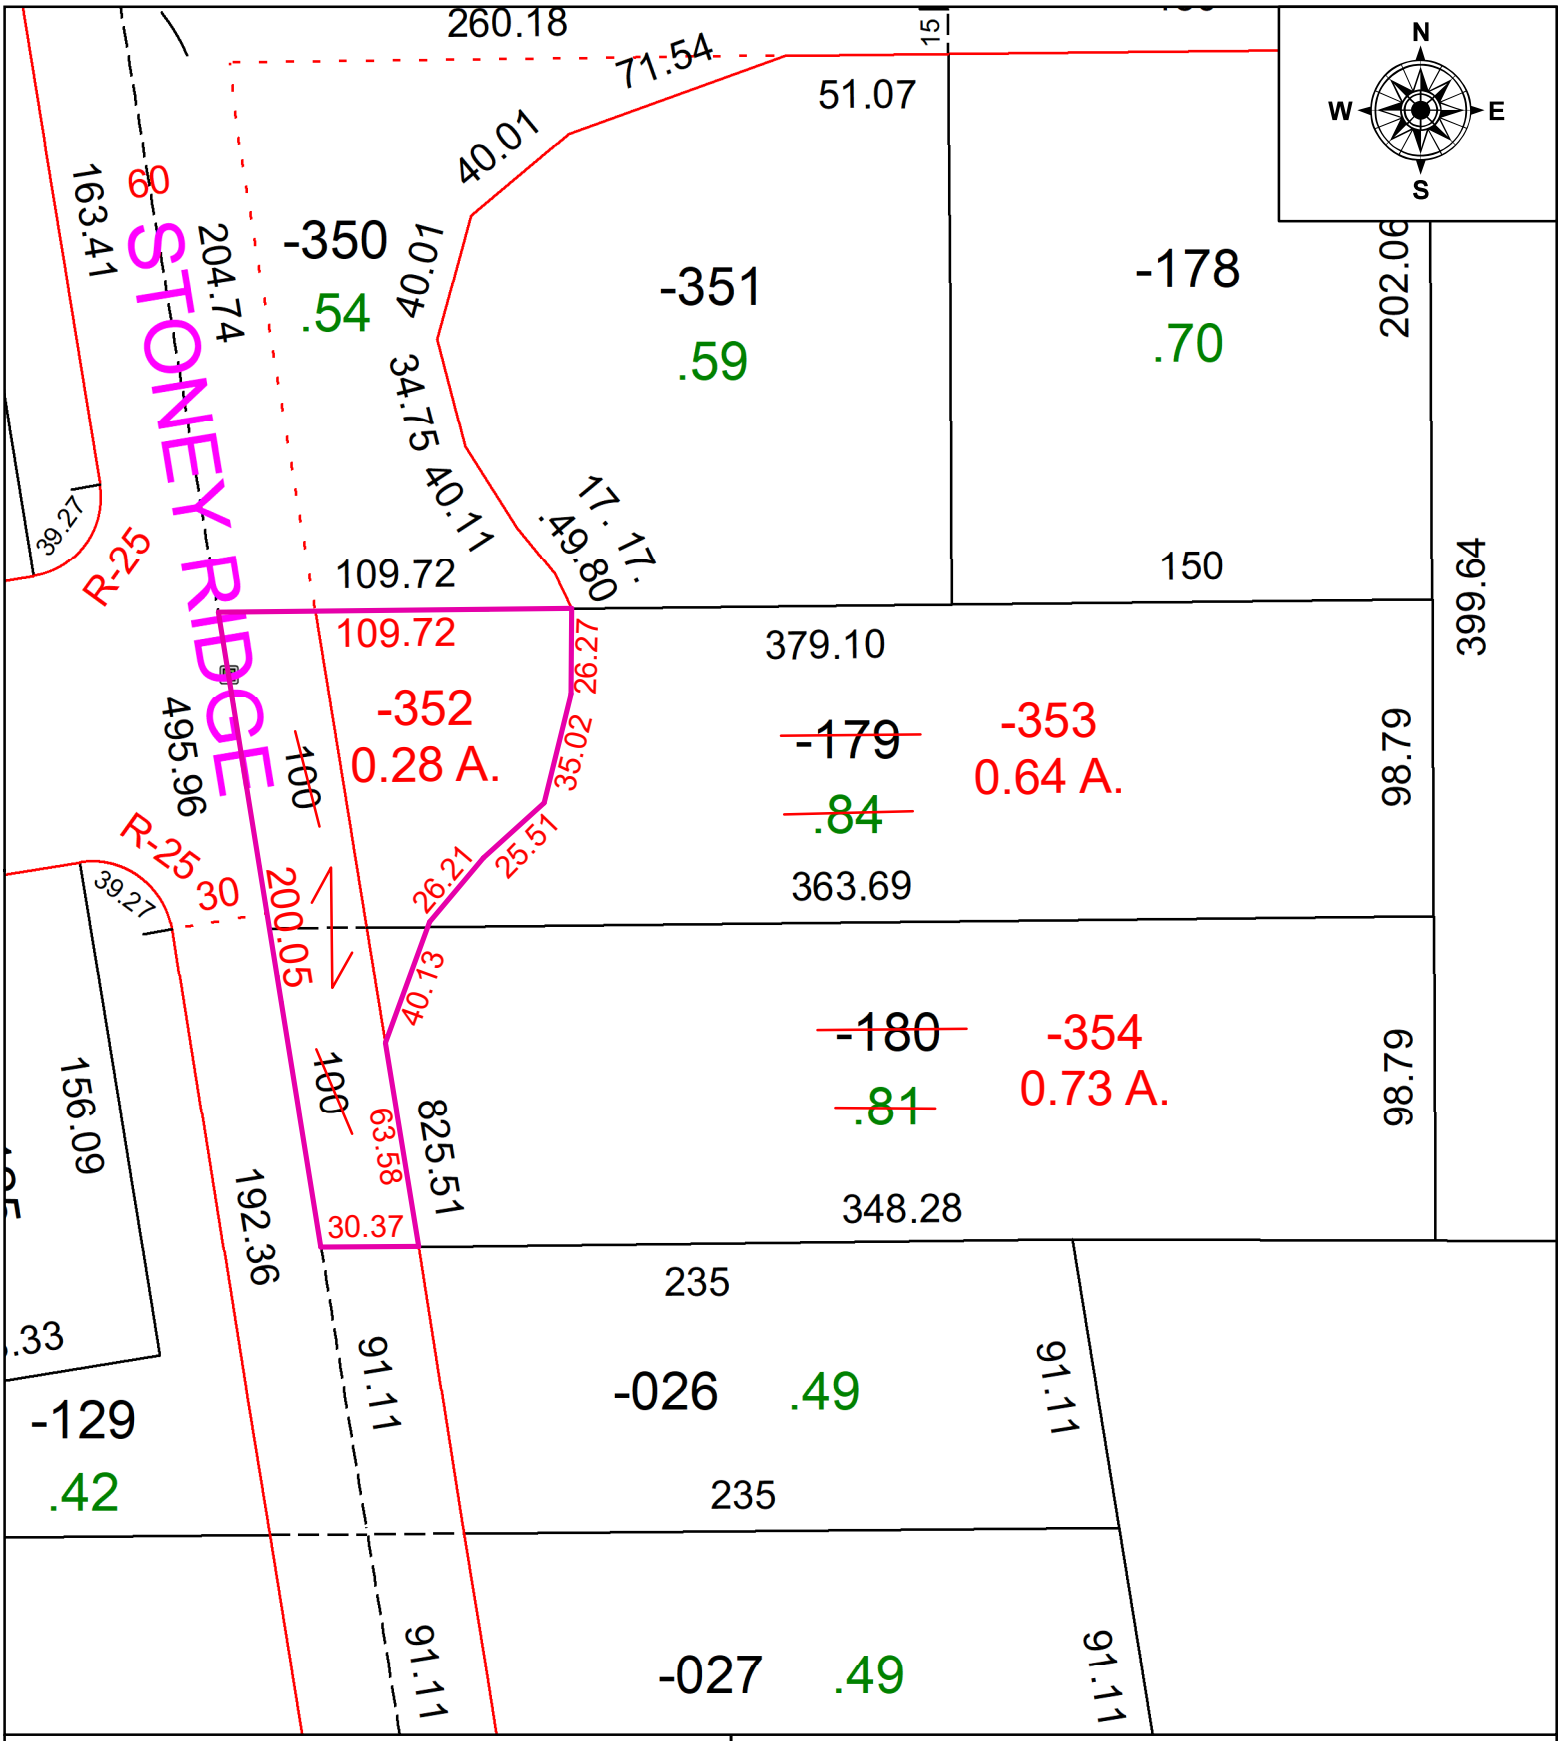

SPLITS/DEEDS PROCESSED
LORAIN COUNTY TAX MAP DEPARTMENT
226 MIDDLE AVE. ELYRIA, OH

SURVEYED BY: BRIAN BINGHAM
CLOSURE: 1:113101
MAP PAGE(S): 7-00-031
APPOVED BY: TJS **DATE:** 8/30/2022
SCALE: 1" = 60' **PRIOR INSTRUMENT:** 2021-0834284 & 2021-0822793