PARENT PARCEL: 07-00-025-101-067
CHILD PARCEL: 07-00-025-101-083 & -084
STARTING POINT: I.P. MON. BOX, CL OF AVON-BELDEN RD. (S.R. 83) & CL OF CHESTNUT RIDGE RD.

22-00786

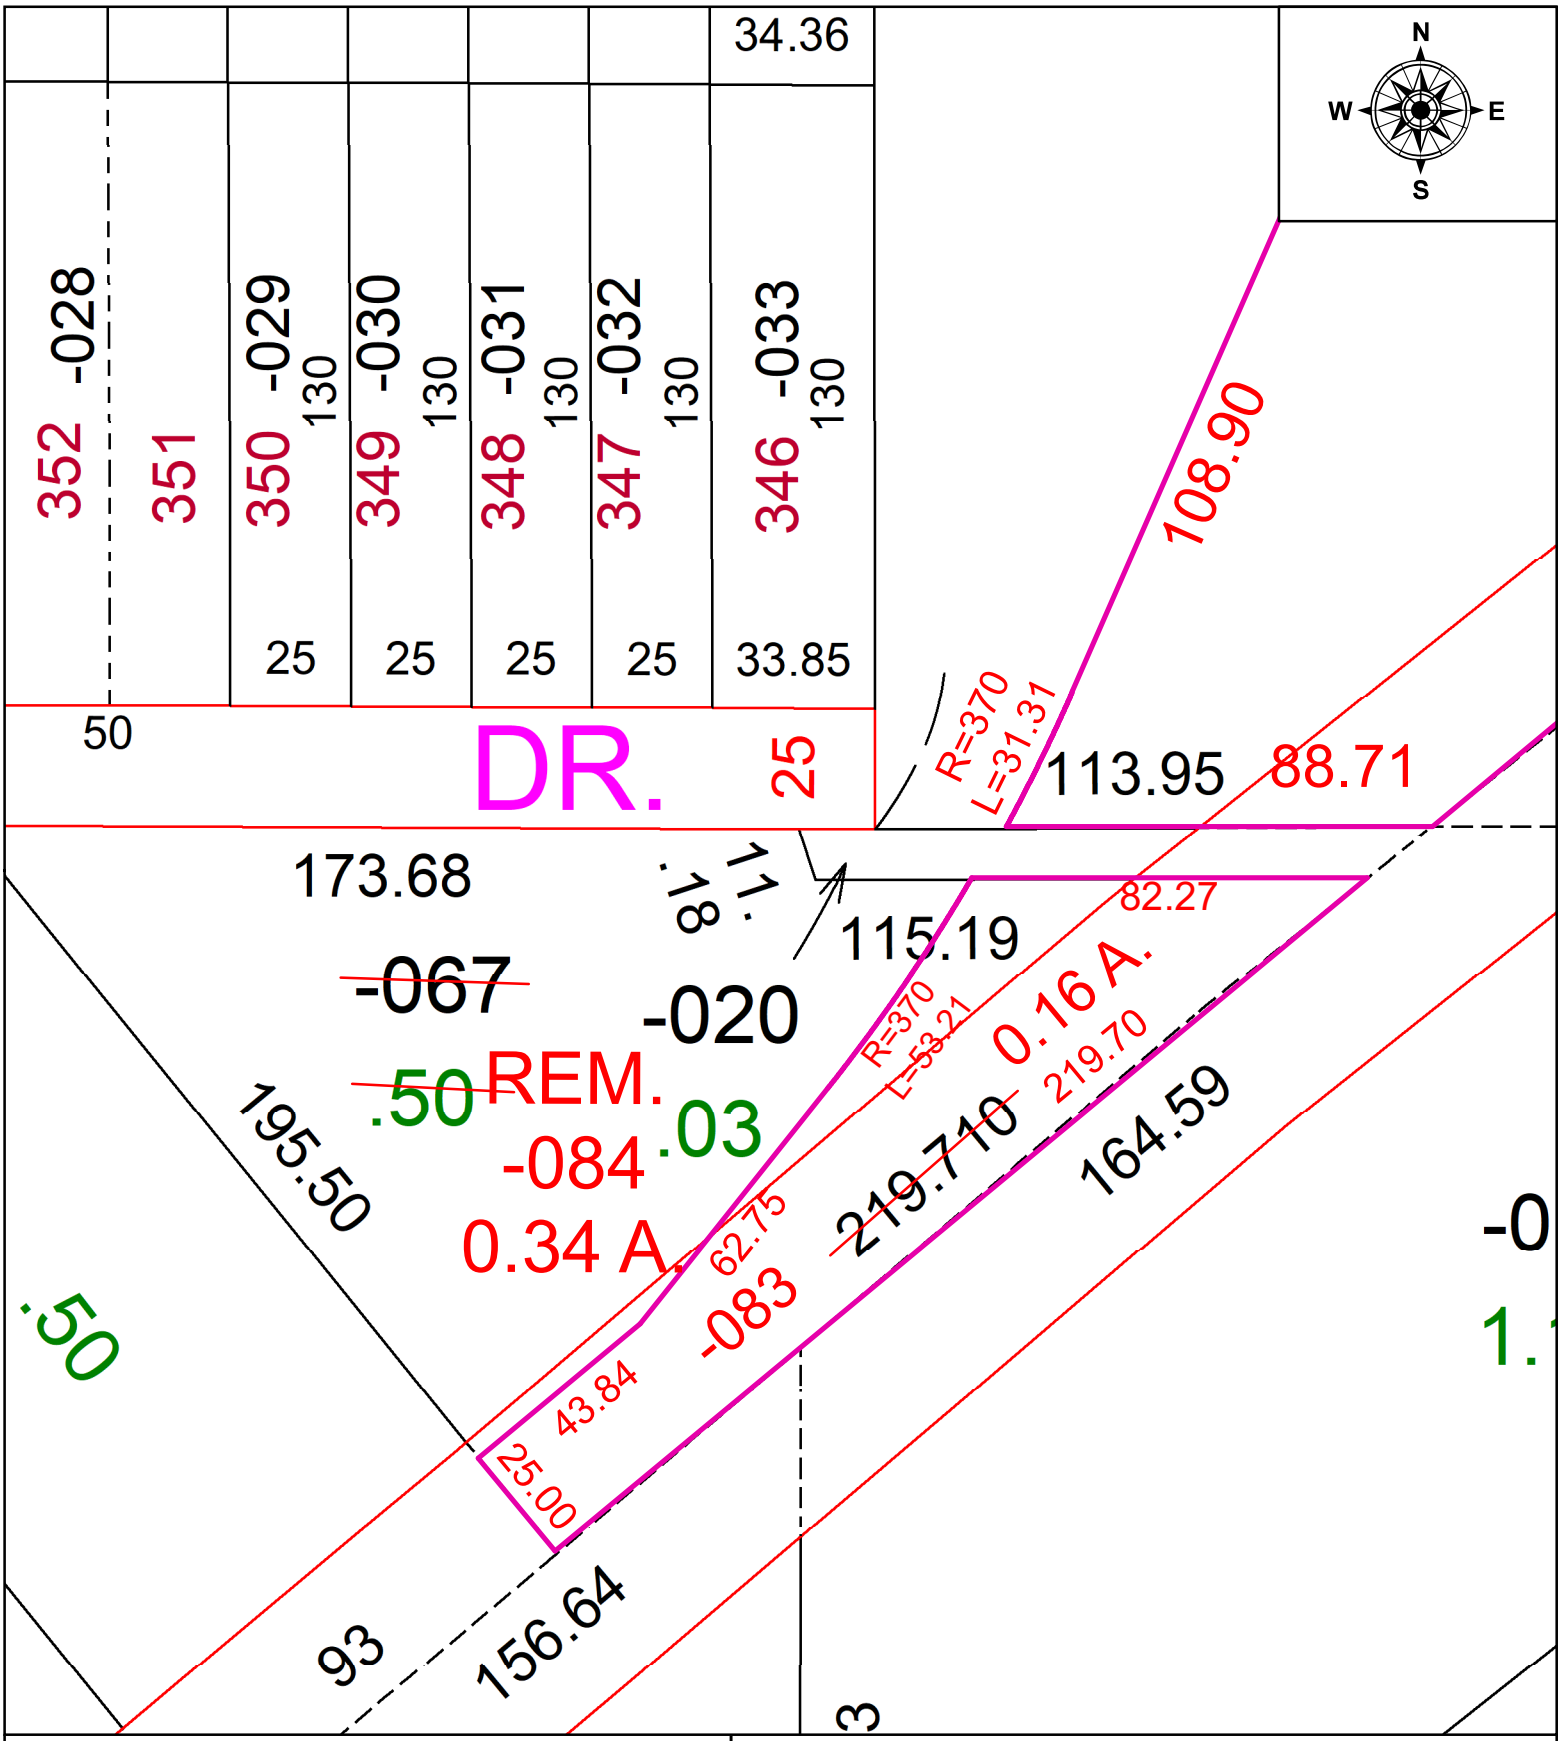

SPLITS/DEEDS PROCESSED
LORAIN COUNTY TAX MAP DEPARTMENT
226 MIDDLE AVE. ELYRIA, OH

SURVEYED BY: MICHAEL J. WARD
CLOSURE: 1:89153
MAP PAGE(S): 07-00-025
APPOVED BY: TJS **DATE:** 10/13/2022
SCALE: 1" = 40' **PRIOR INSTRUMENT:** 2019-0728787