PARENT PARCEL: 02-02-024-111-002
CHILD PARCEL: 02-02-024-111-003 & -004
STARTING POINT: MAG NAIL SET, S.W. CORNER OF S/L 1 OF LMHA-WESTGATE SUB.

23-00790

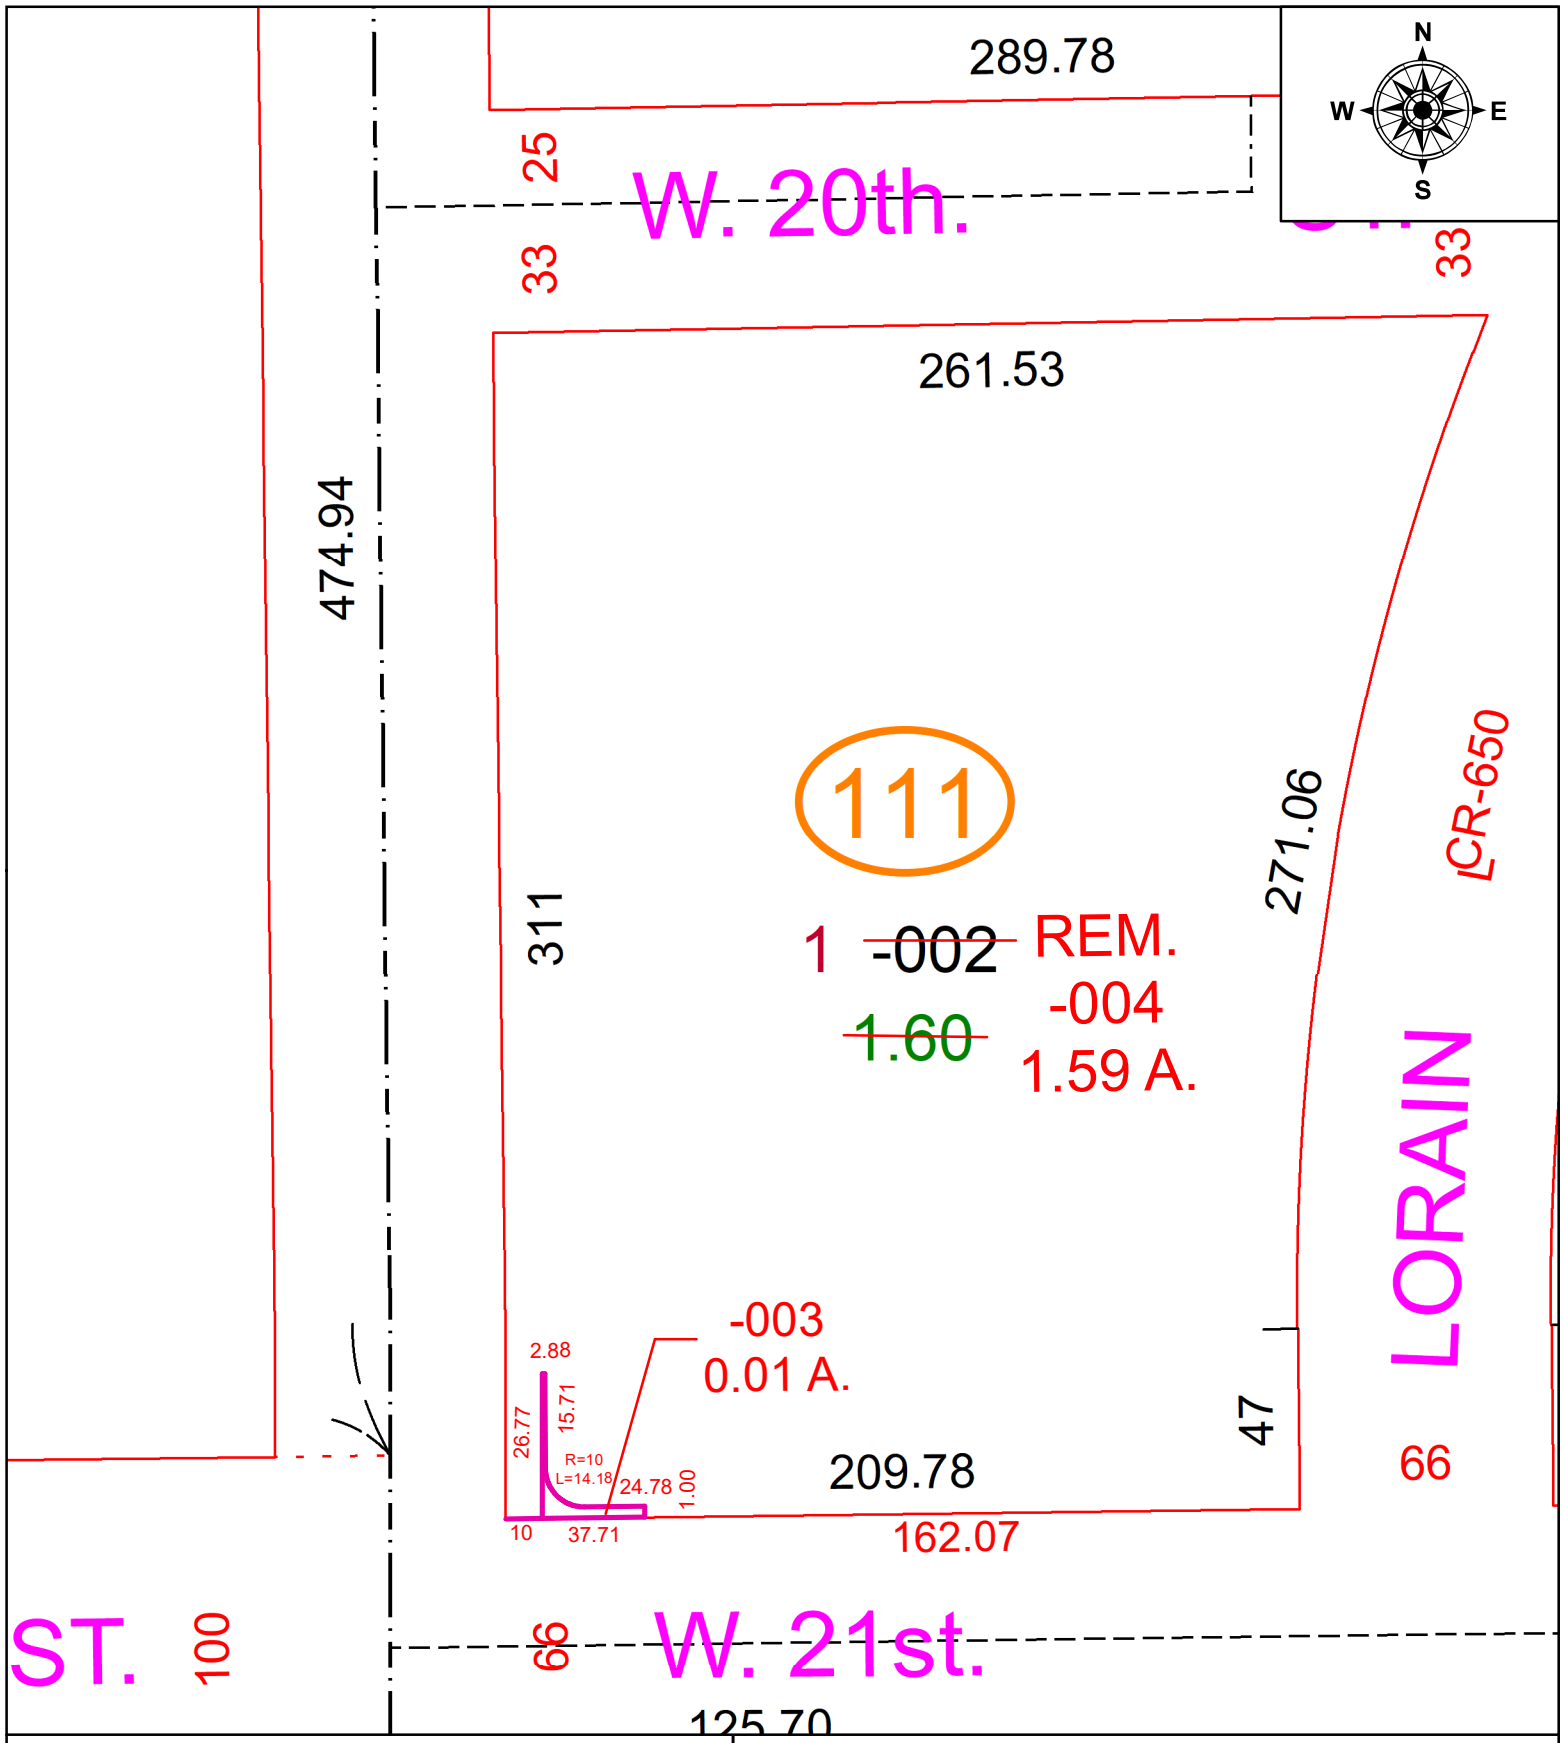

SPLITS/DEEDS PROCESSED
LORAIN COUNTY TAX MAP DEPARTMENT
226 MIDDLE AVE. ELYRIA, OH

SURVEYED BY: TRAVIS McCARTY
CLOSURE: 1: INF
MAP PAGE(S): 02-02-024
APPOVED BY: TJS **DATE:** 4/5/2023
SCALE: 1" = 50' **PRIOR INSTRUMENT:** PV 98 PG. 8