PARENT PARCEL: 07-00-006-101-099

CHILD PARCEL: 07-00-005-102-003 & 07-00-006-101-166 3WD LOR-20-24397

STARTING POINT: 1/2" I.P. MON. BOX, CL OF BROOKSTONE LANE IN CREEKSTONE COMMONS CONDO PH. 1 IN PV. 33 PG. 64

24-00794

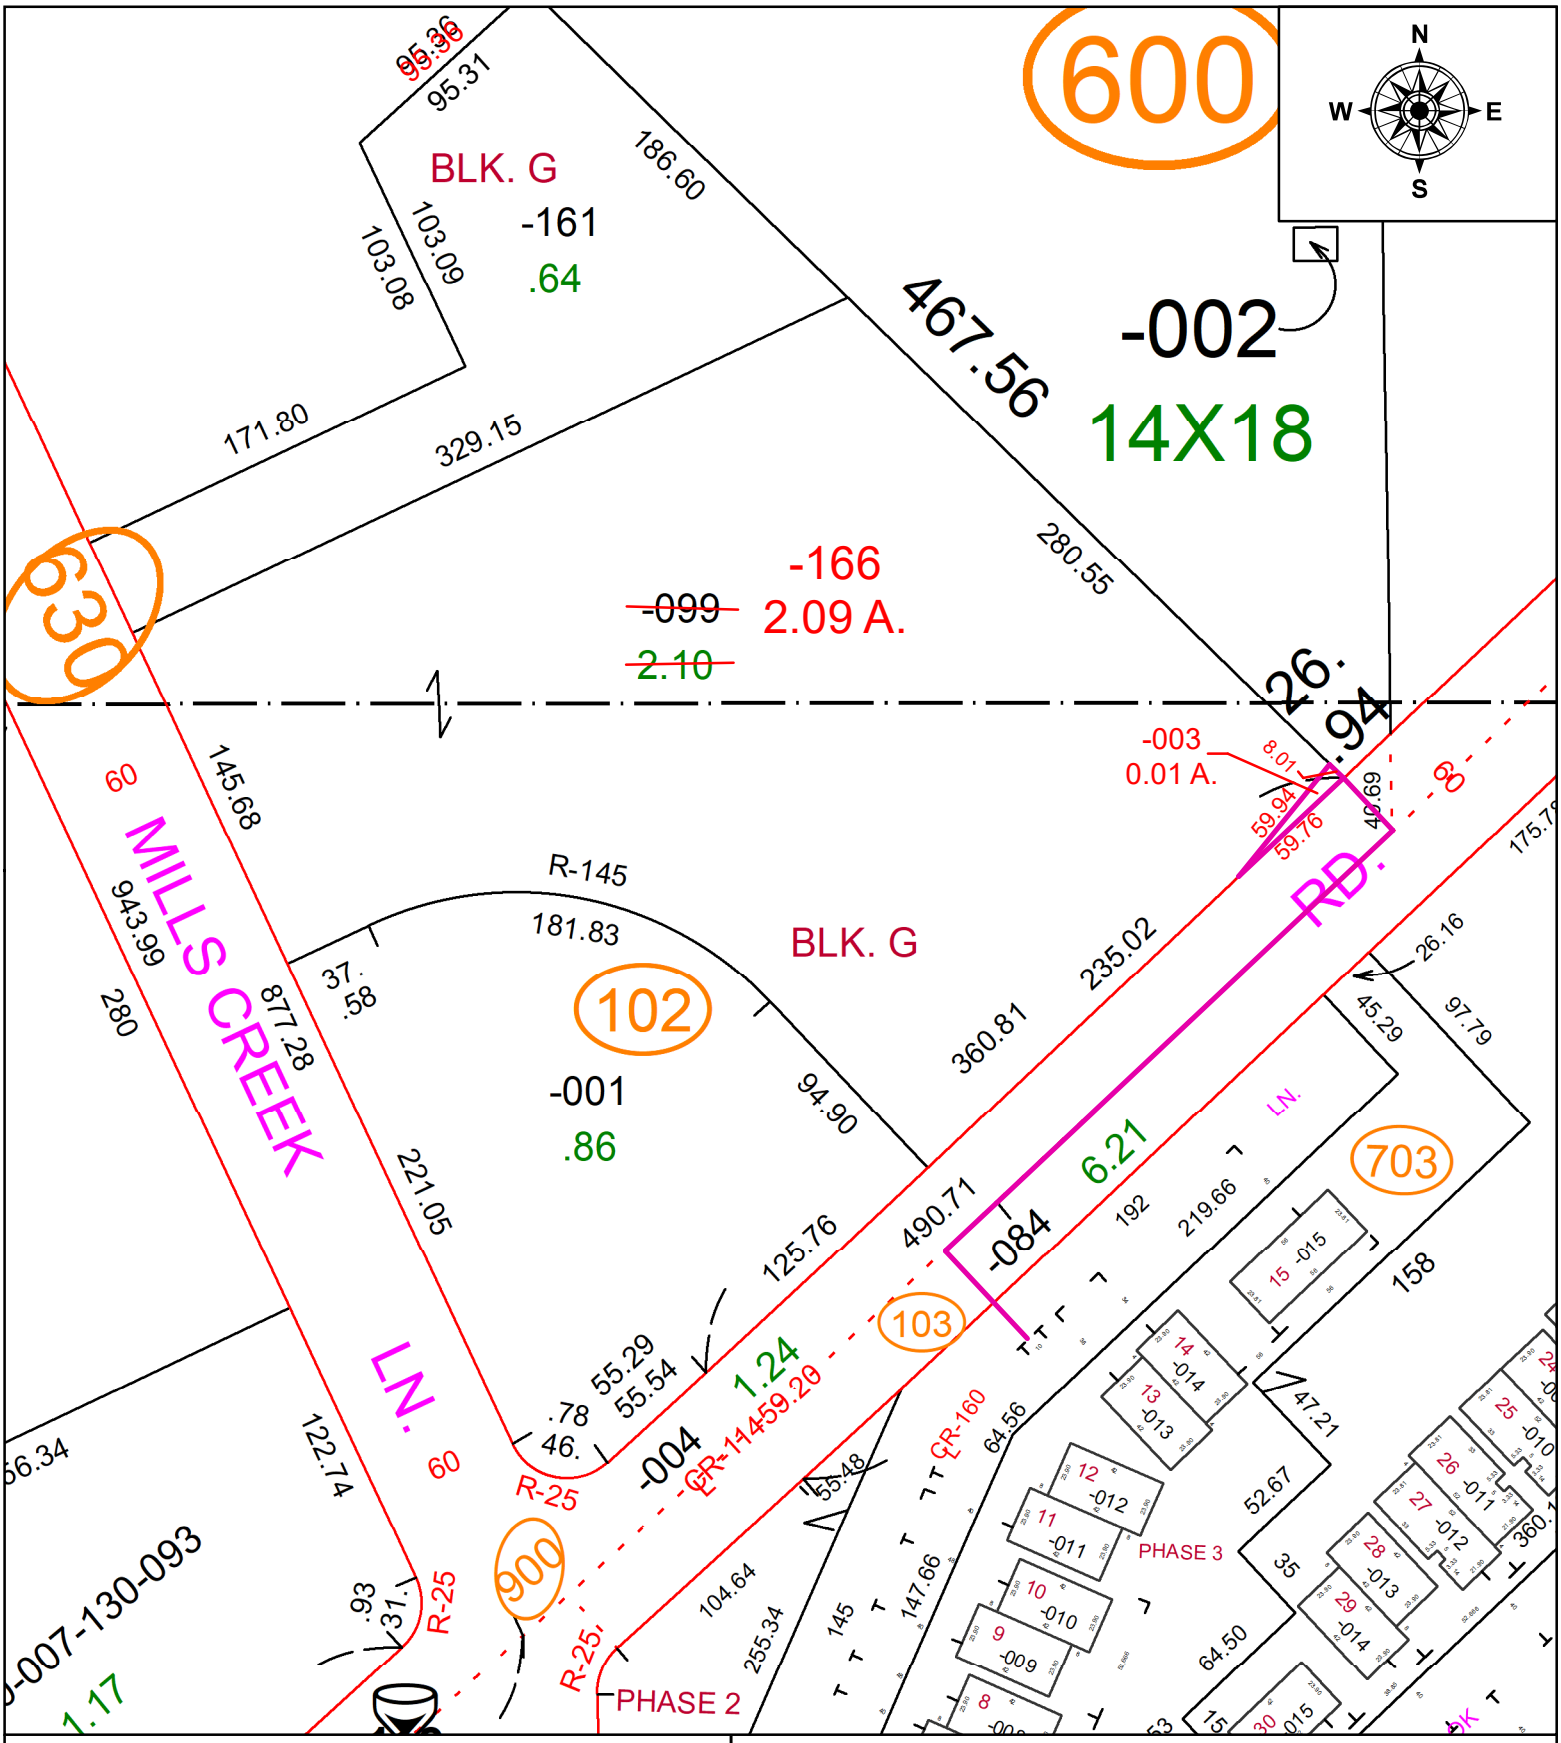

SPLITS/DEEDS PROCESSED

LORAIN COUNTY TAX MAP DEPARTMENT
226 MIDDLE AVE. ELYRIA, OH

SURVEYED BY: JOSHUA R. MIHELCIC
CLOSURE: 1:47814
MAP PAGE(S): 07-00-005 & -006
APPOVED BY: TJS **DATE:** 4/5/2024
SCALE: 1" = 80' **PRIOR INSTRUMENT:** 2021-0838764