PARENT PARCEL: 07-00-006-101-103

CHILD PARCEL: 07-00-006-101-167 & -168 5WD LOR-20-24397

STARTING POINT: 1/2" I.P. MON. BOX, CL OF BROOKSTONE LANE IN CREEKSTONE COMMONS CONDO PH. 1 IN PV. 33 PG. 64

24-00795

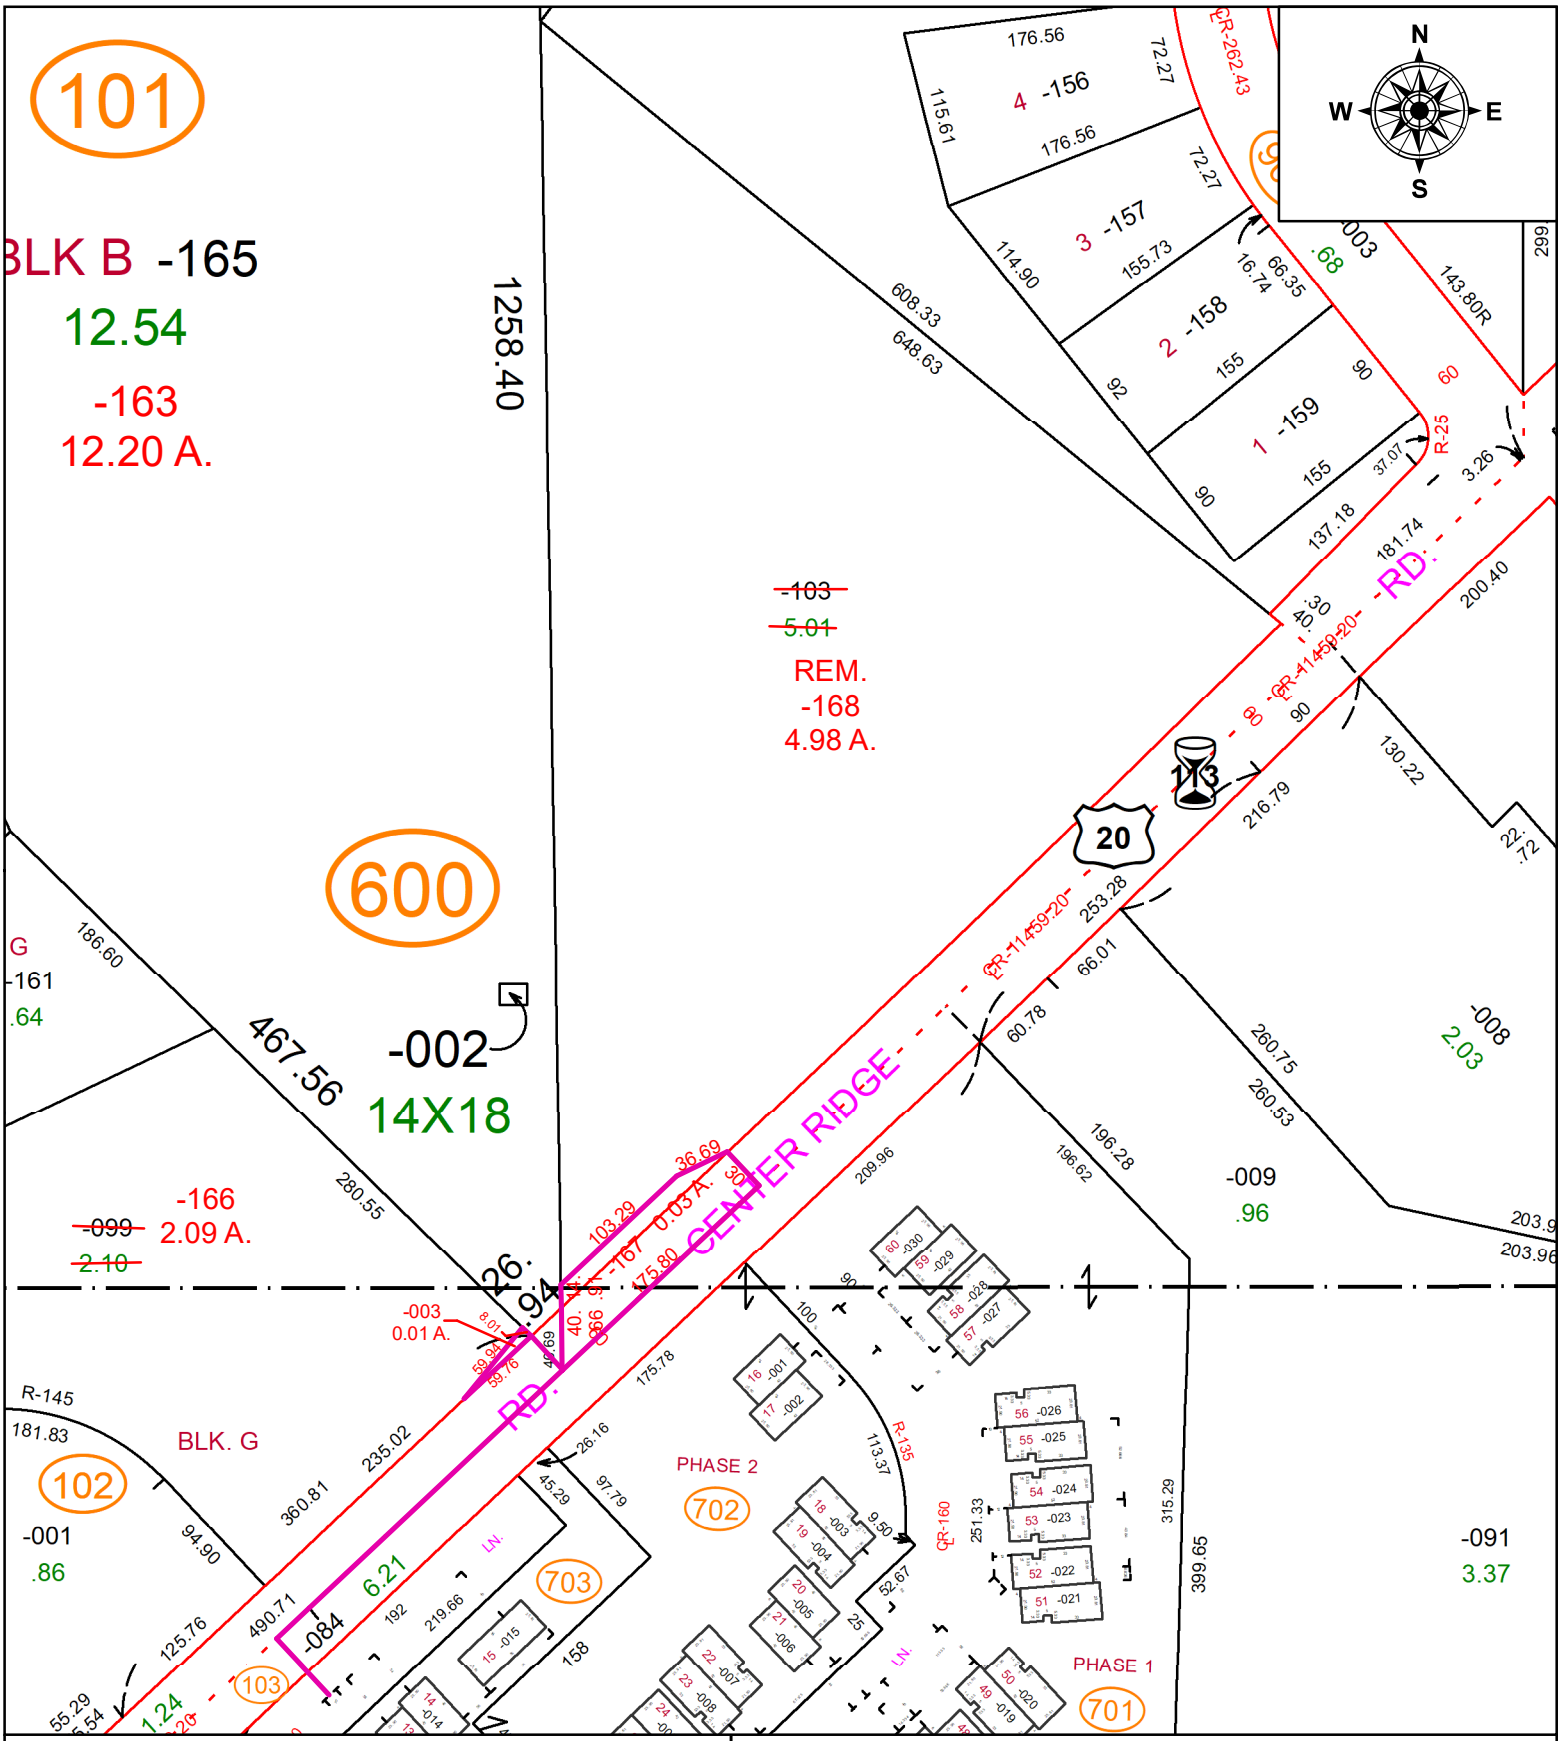

SPLITS/DEEDS PROCESSED

LORAIN COUNTY TAX MAP DEPARTMENT
226 MIDDLE AVE. ELYRIA, OH

SURVEYED BY: JOSHUA R. MIHELCIC
CLOSURE: 1:103729
MAP PAGE(S): 07-00-005 & -006
APPOVED BY: TJS **DATE:** 4/5/2024
SCALE: 1" = 125' **PRIOR INSTRUMENT:** PV. 115 PG. 16