PARENT PARCEL: 12-00-014-000-013

CHILD PARCEL: 12-00-015-000-101 & 12-00-014-000-014

STARTING POINT: I.P. MON. BOX, CL OF ELYRIA-TWINSBURG RD. (S.R. 82) & CL OF BOONE RD.

24-00801

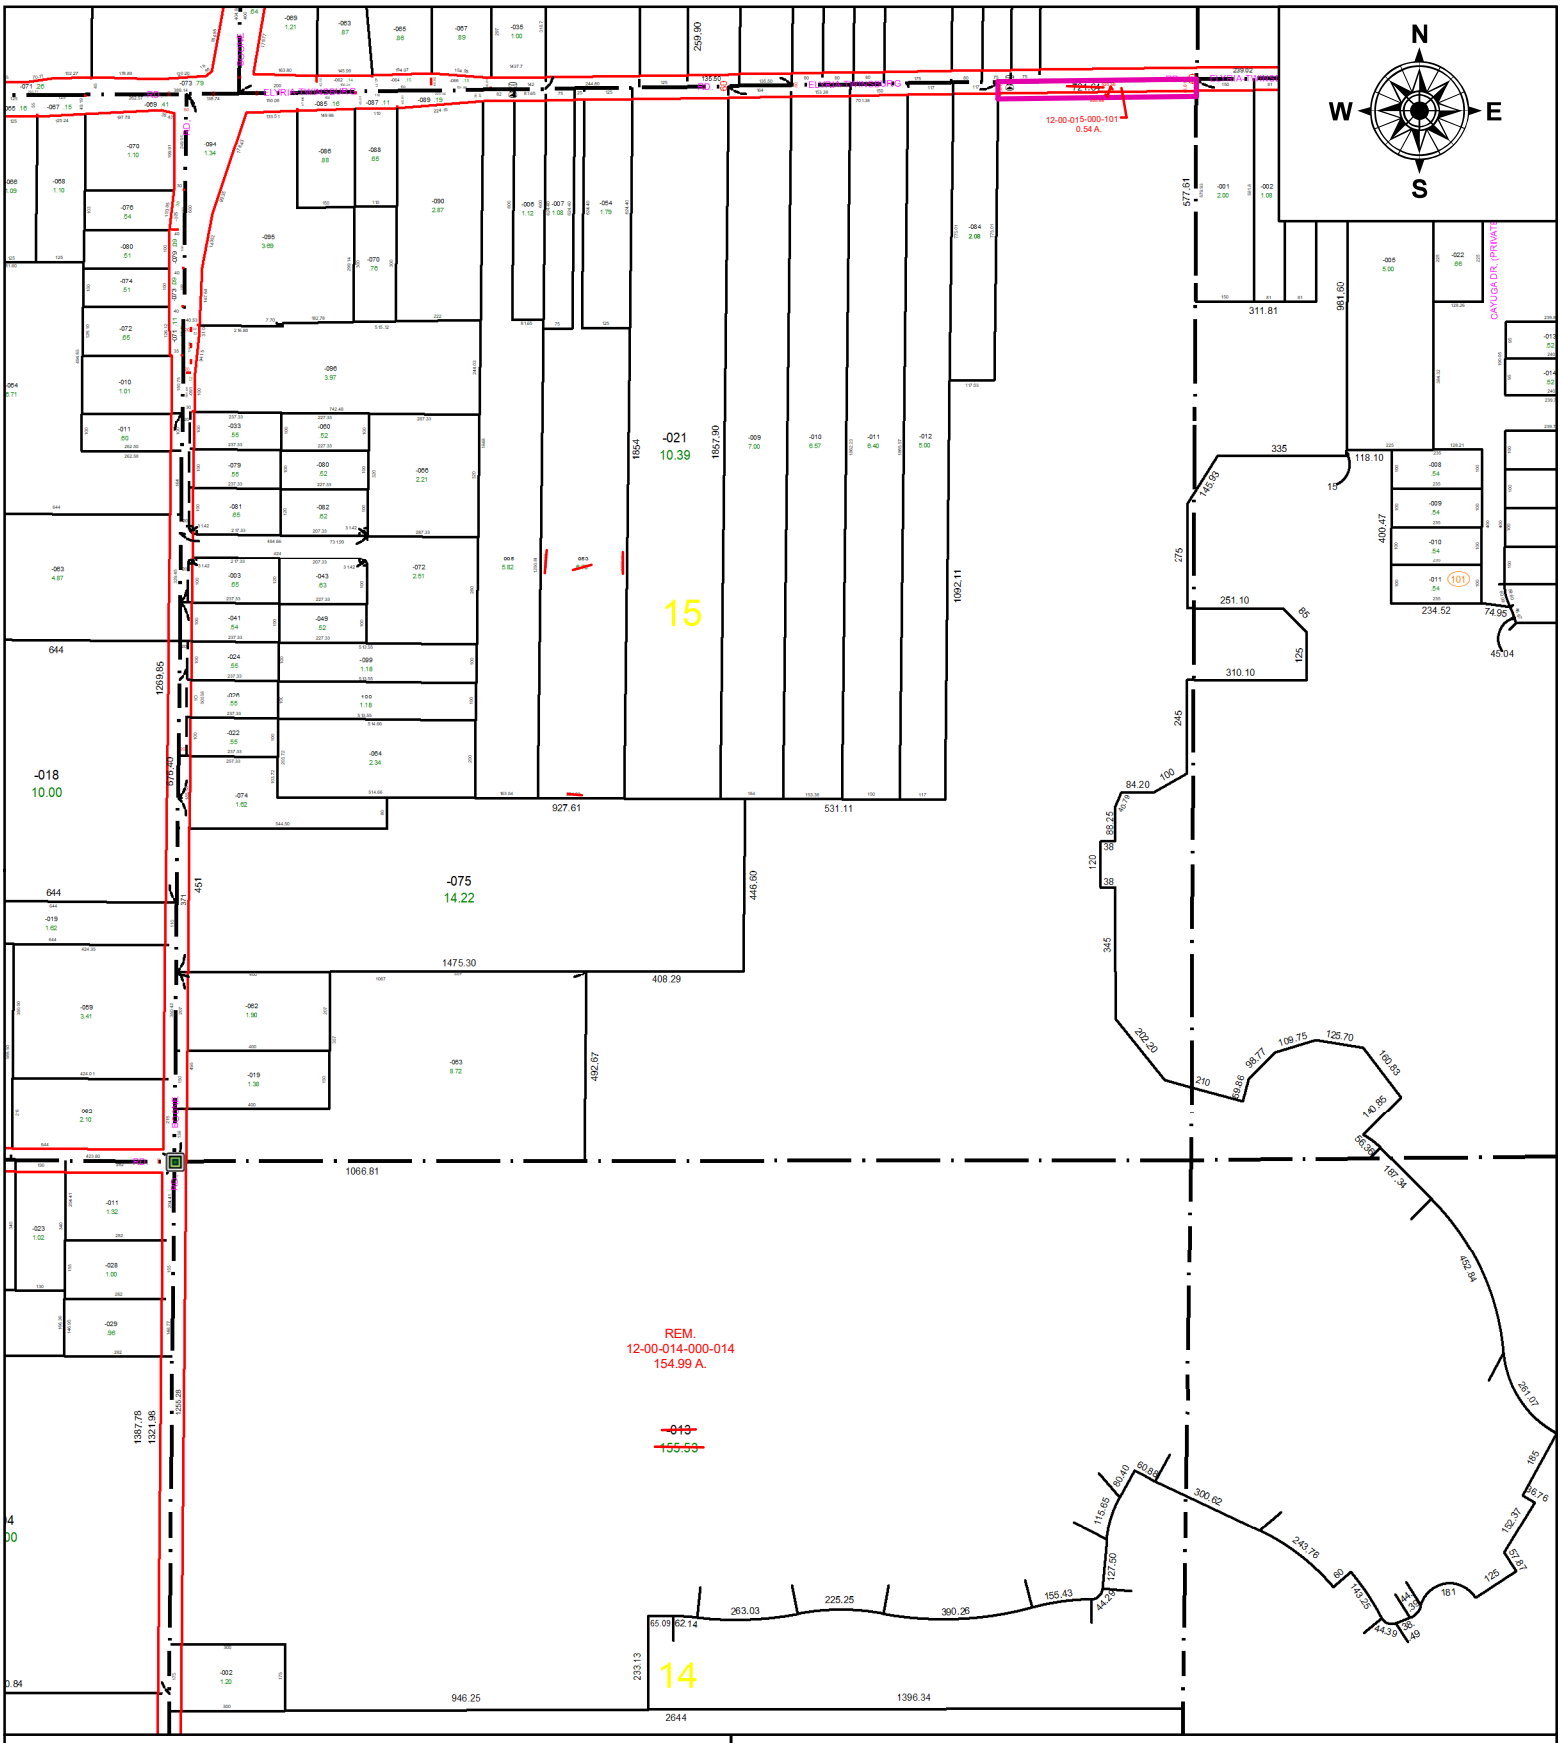

SPLITS/DEEDS PROCESSED

LORAIN COUNTY TAX MAP DEPARTMENT
226 MIDDLE AVE. ELYRIA, OH

SURVEYED BY: M. ACKERMAN
CLOSURE: 1: INF
MAP PAGE(S): 12-00-015 & -014
APPOVED BY: TJS **DATE:** 10/7/2024
SCALE: 1" = 500' **PRIOR INSTRUMENT:** 2024-0013608