PARENT PARCEL: 03-00-040-104-005 & -026

CHILD PARCEL: 03-00-040-104-041 & -042 2WD LOR-US-6-13.69

STARTING POINT: MAG. NAIL, CL OF LAKE RD. & CL OF GRANTWOOD AVE.

24-00803

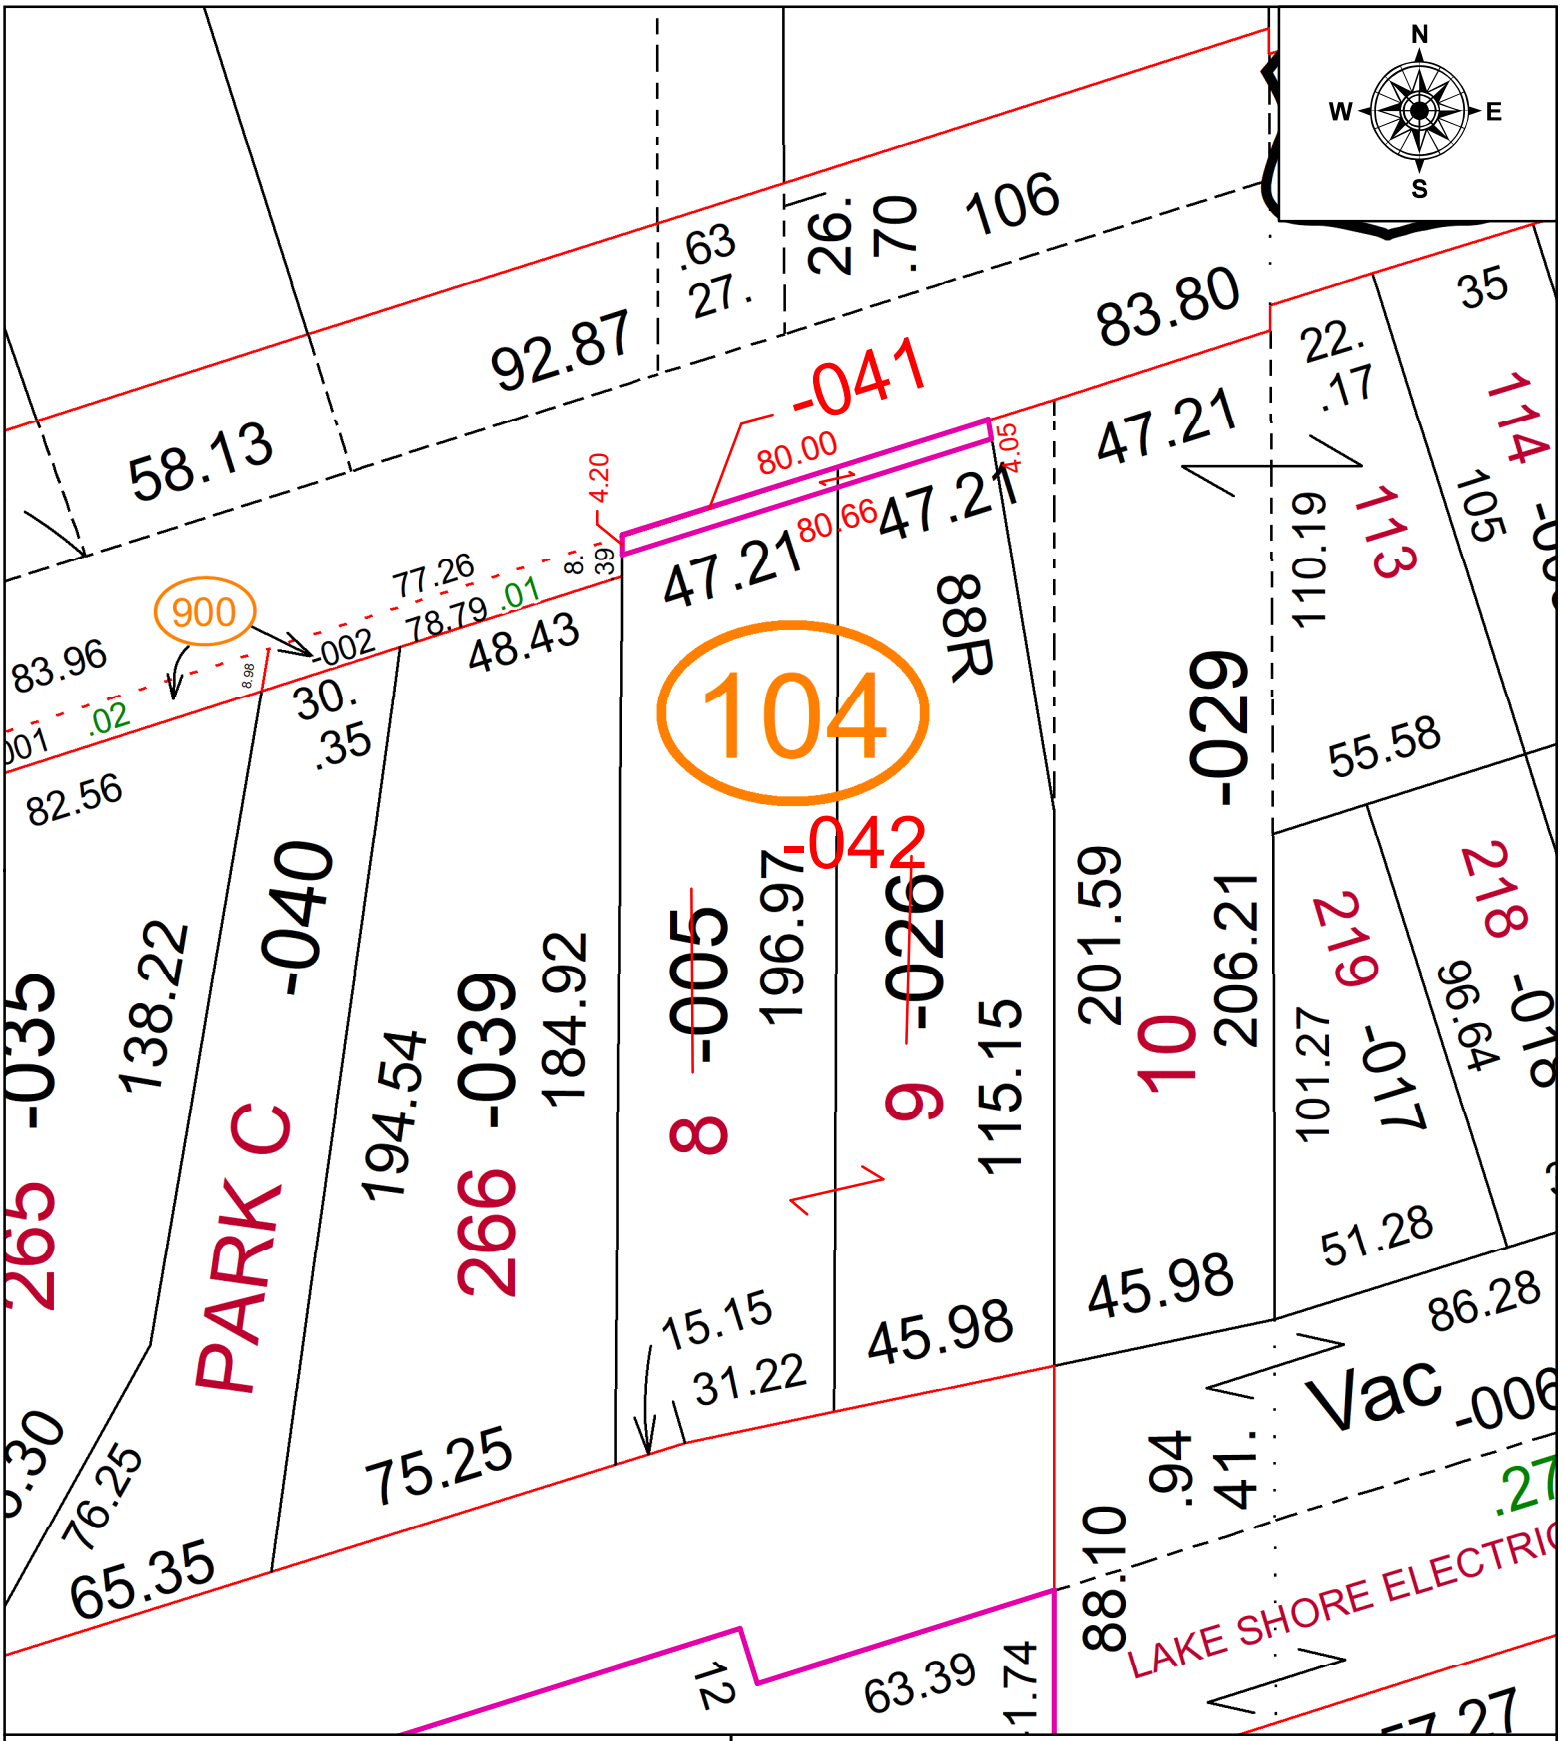

SPLITS/DEEDS PROCESSED

LORAIN COUNTY TAX MAP DEPARTMENT
226 MIDDLE AVE. ELYRIA, OH

SURVEYED BY: AMY KELLY
CLOSURE: 1: INF
MAP PAGE(S): 03-00-040
APPOVED BY: TJS **DATE:** 11/1/2024
SCALE: 1" = 40' **PRIOR INSTRUMENT:** 2019-0737440