PARENT PARCEL: 03-00-040-104-029 & -009

CHILD PARCEL: 03-00-040-104-043 THRU -046 3-WD1 & 3-WD2 LOR-US-6-13.69

STARTING POINT: MAG. NAIL, CL OF LAKE RD. & CL OF GRANTWOOD AVE.

24-00804

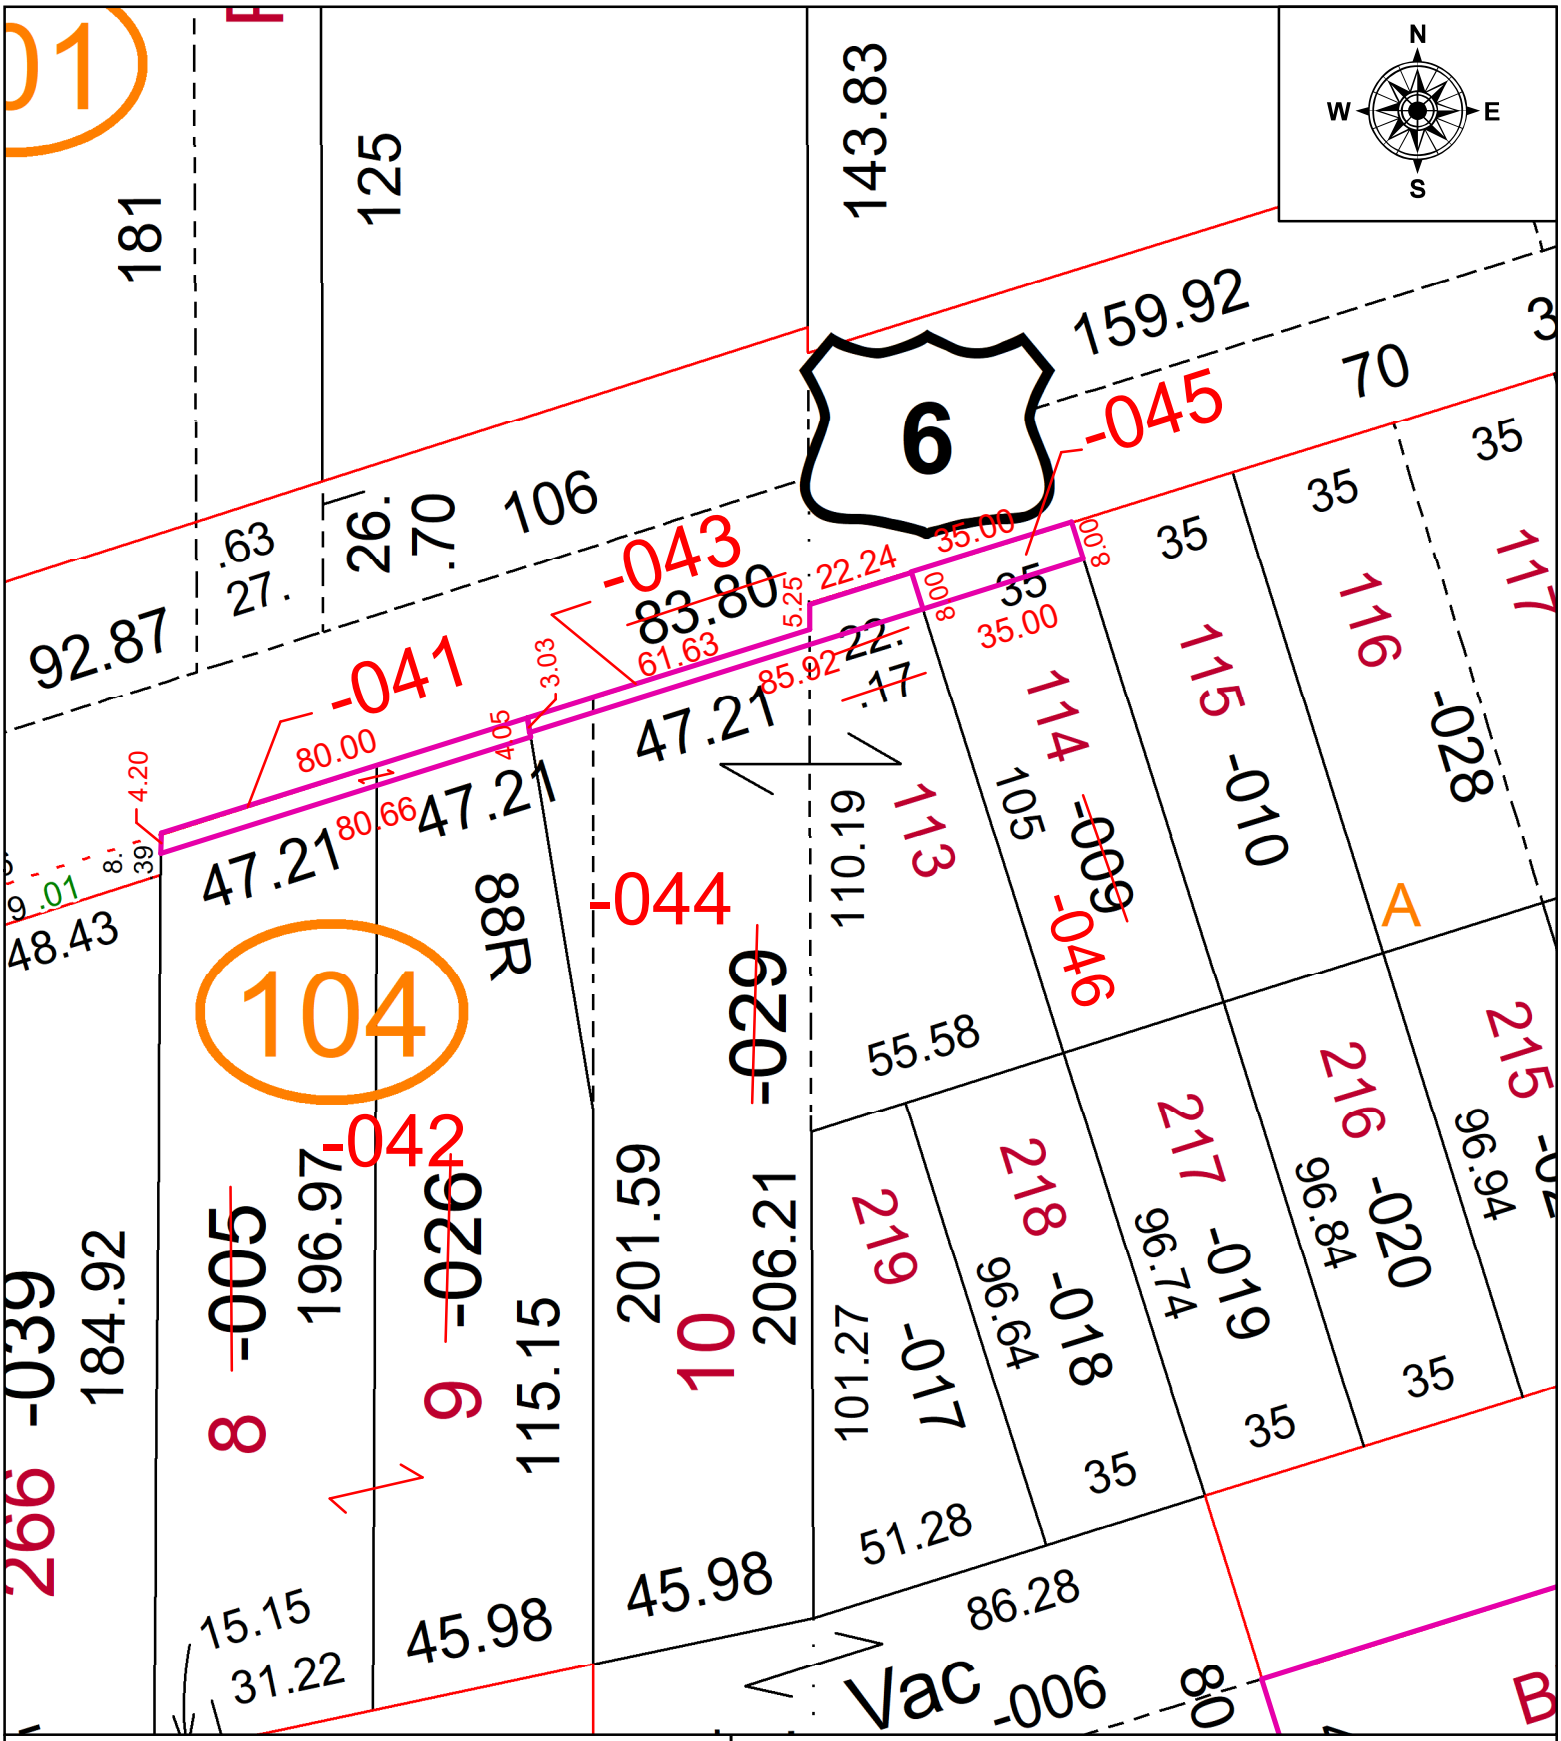

SPLITS/DEEDS PROCESSED

LORAIN COUNTY TAX MAP DEPARTMENT
226 MIDDLE AVE. ELYRIA, OH

SURVEYED BY: AMY KELLY
CLOSURE: 1: INF
MAP PAGE(S): 03-00-040
APPOVED BY: TJS **DATE:** 11/1/2024
SCALE: 1" = 40' **PRIOR INSTRUMENT:** 2012-0433629