PARENT PARCEL: 03-00-039-105-003

CHILD PARCEL: 03-00-039-105-054 & -055 13-WD LOR-US-6-13.69

STARTING POINT: MAG. NAIL, CL OF LAKE RD. & CL OF KENILWORTH AVE.

24-00806

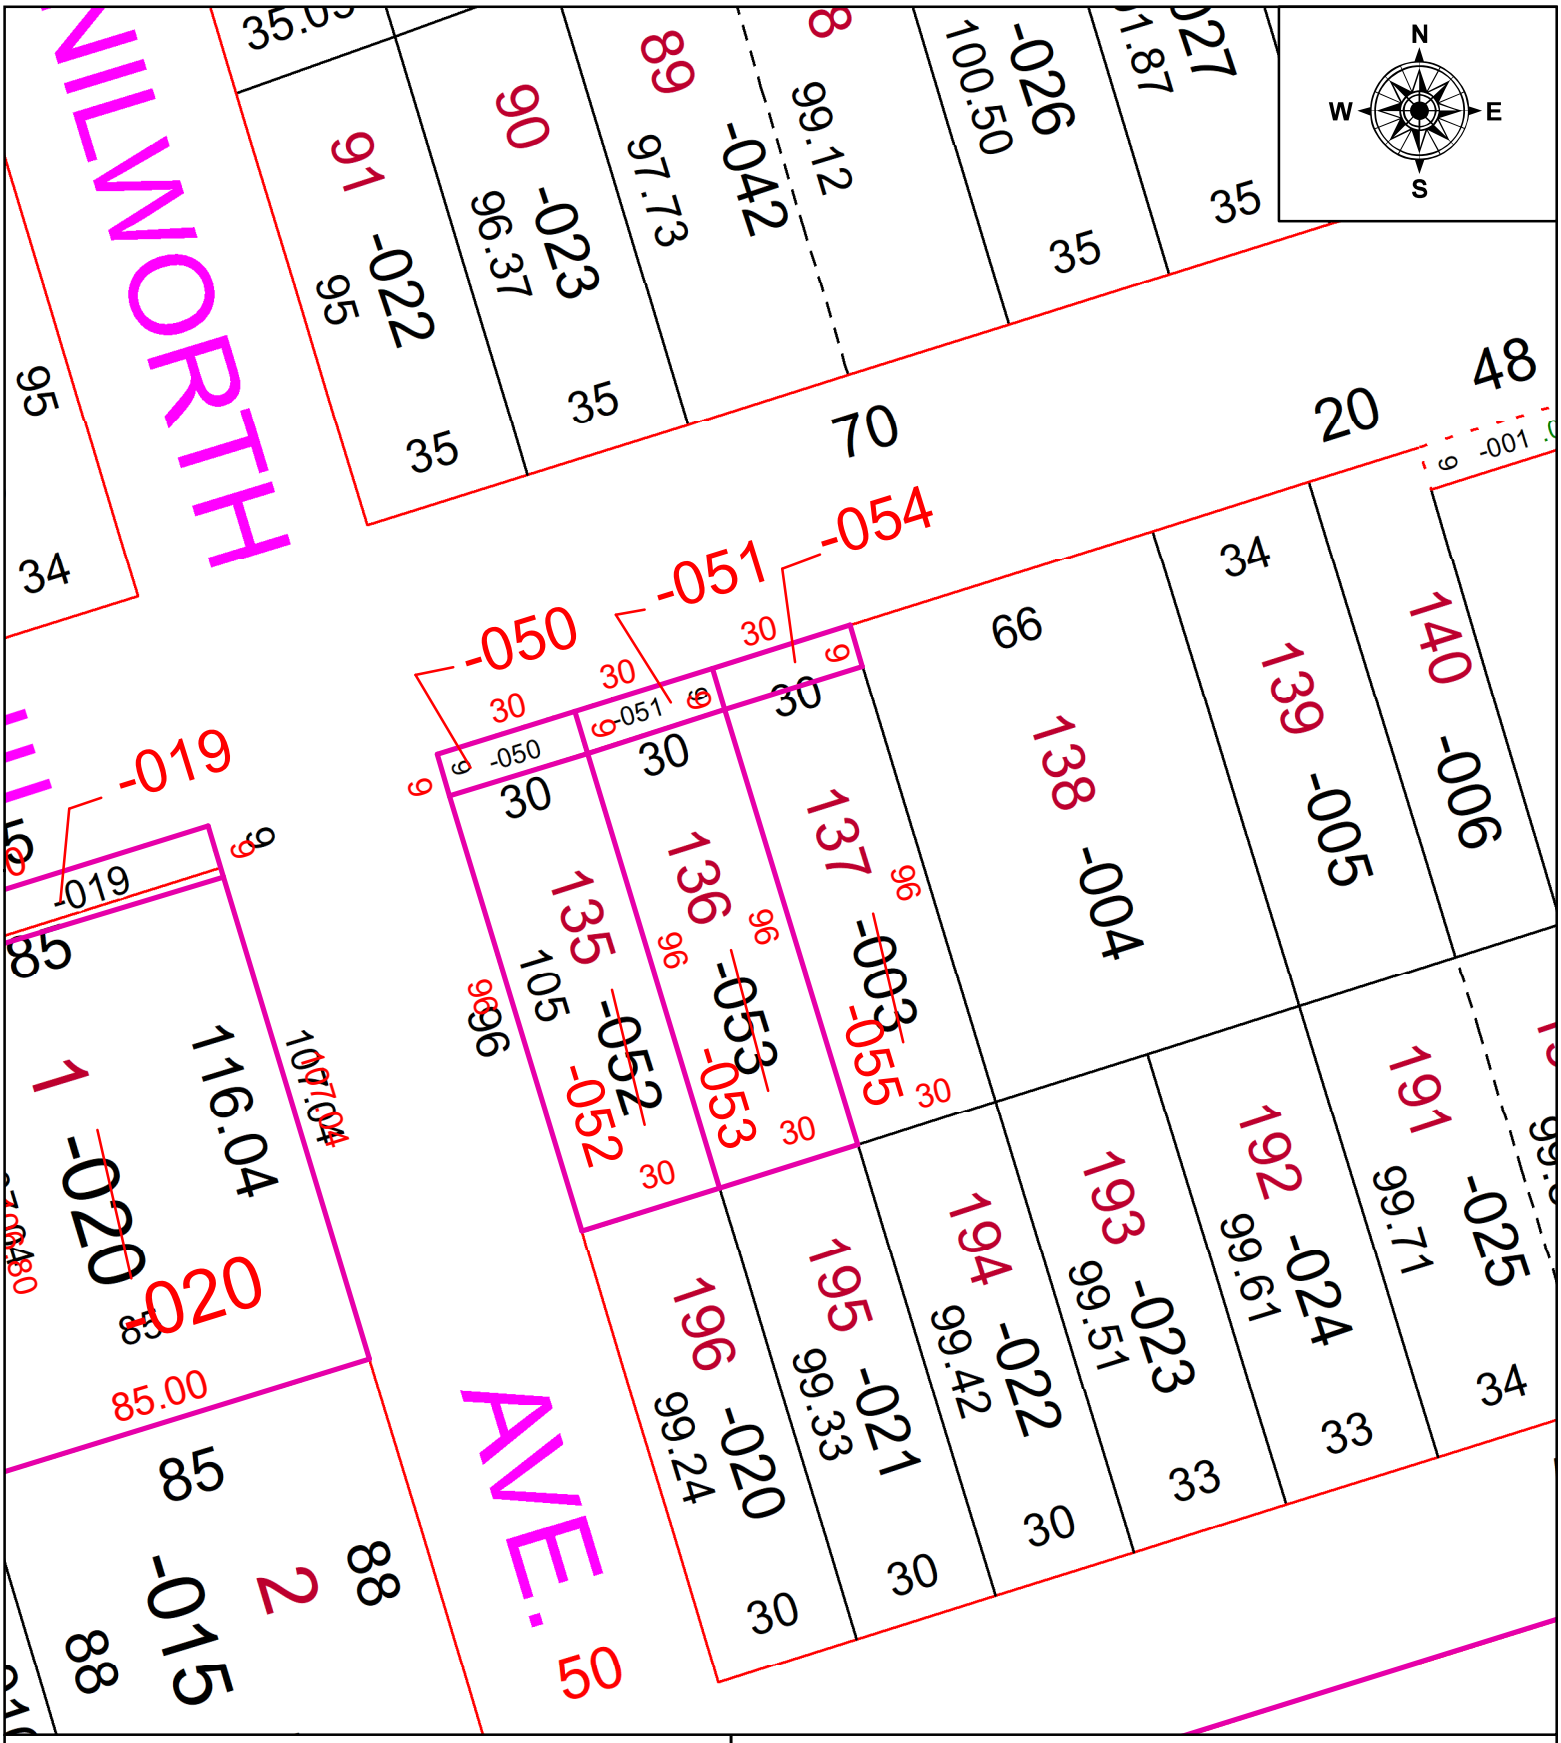

SPLITS/DEEDS PROCESSED

LORAIN COUNTY TAX MAP DEPARTMENT
226 MIDDLE AVE. ELYRIA, OH

SURVEYED BY: AMY KELLY
CLOSURE: 1: INF
MAP PAGE(S): 03-00-040
APPOVED BY: TJS **DATE:** 11/6/2024
SCALE: 1" = 40' **PRIOR INSTRUMENT:** 1996-0420257